


RECEIVED

NOV 1 1951
STATE ENGINEER
SALEM, OREGON

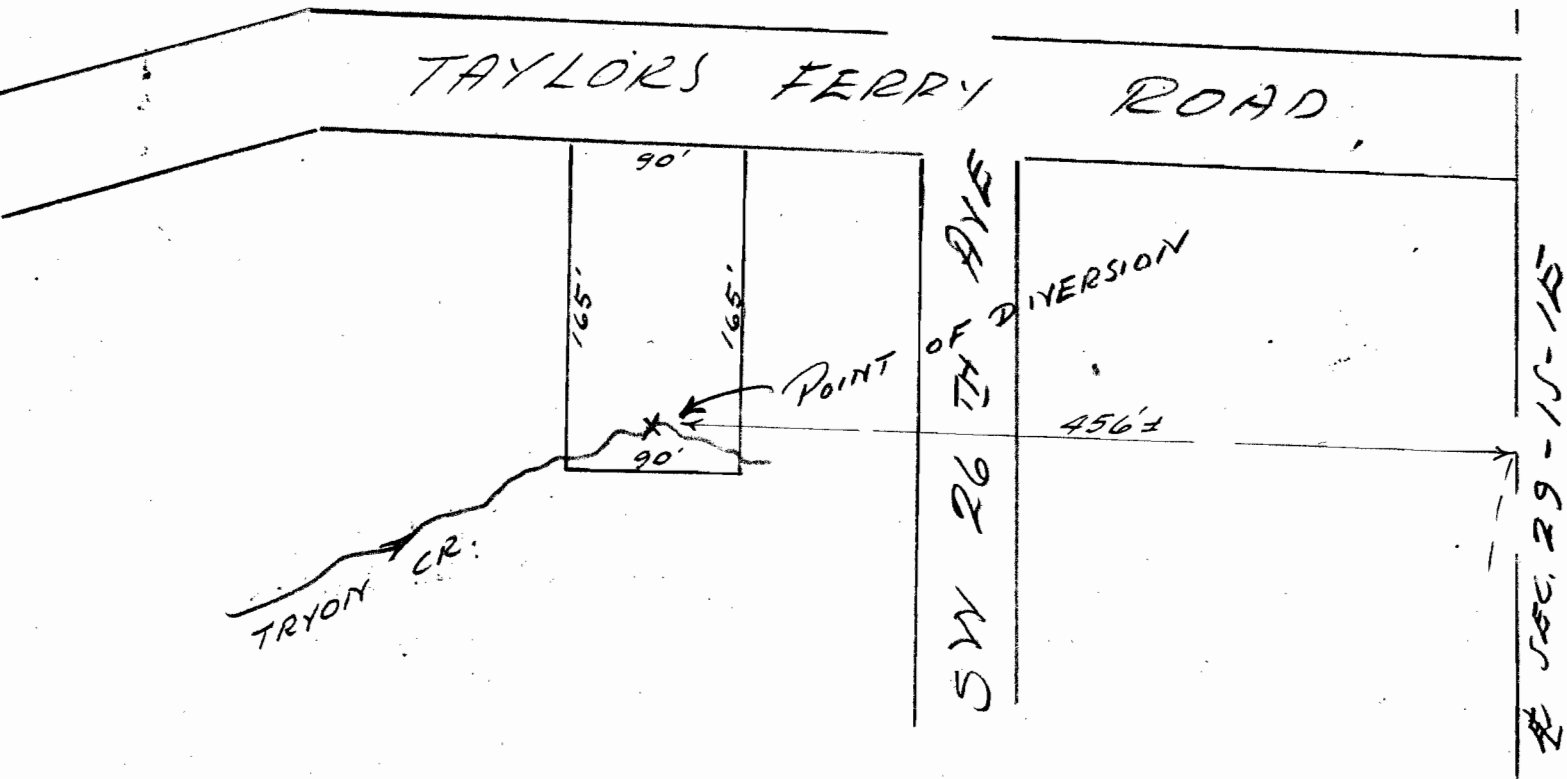

Application No. 26606
Permit No. 20839

E 1/4 LOT 12 →
SEC 29-15-1E
WM

20839