
## T. L. HALL IRRIGATION WORKS SECS. 19 & 20, T. 12 S., R. I W., W. M.

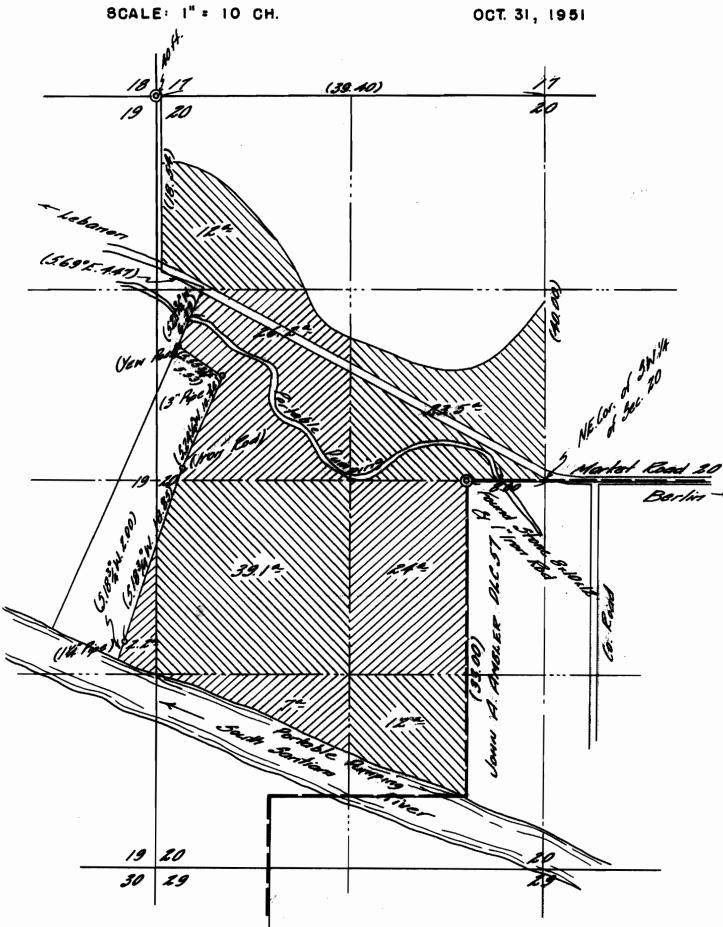

I, Orris A. Carnegie, of Albany, Oregon, do hereby certify that this map was made from notes taken during an actual survey made under my immediate supervision on October 31, 1951, and supplemented by information taken from County Survey No. 755 made by C. H. Leonard in Jan. 1919, and from latest aerial photographs; that the monument shown on this map consisting of a stone 8" x 10" x 12" and a 1" iron rod is at the most Northerly Northwest corner of the John A. Ambler D.L.C.No. 57 in T.12 S., R. 1W. of the W. M. (being also West 8.00 chains from the Northeast corner of the Southwest 1 of Section 20 in said Township and Range.

Application No. 26630 Permit No. 20862

OREGON
LAND SURVEYOR

One O. Carrege

MAY 9. 1947

ORRIS A. CARNEGIE 213