


SECTION 13 TOWNSHIP 3 S RANGE 8 1/2 E W.M.
CLACKMAS CO ORE,



14

13

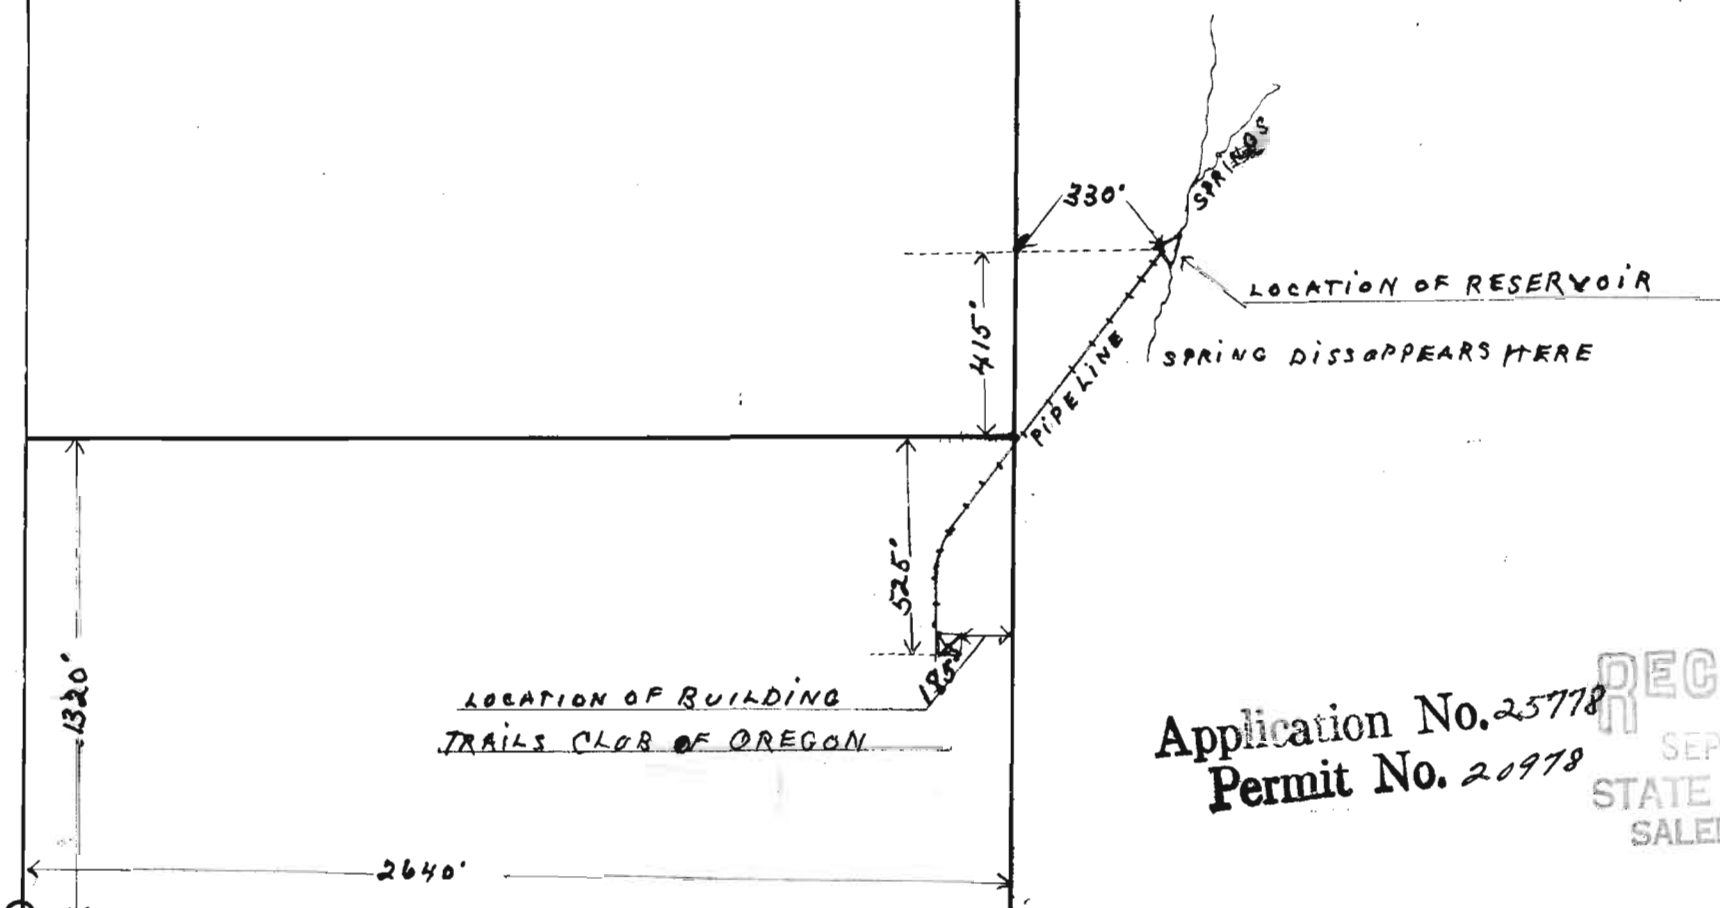

Application No. 25778
Permit No. 20978

RECEIVED
SEP 25 1951
STATE ENGINEER
SALEM, OREGON