


Sec. 5, T. 39 S., R. 1 W. W. M.

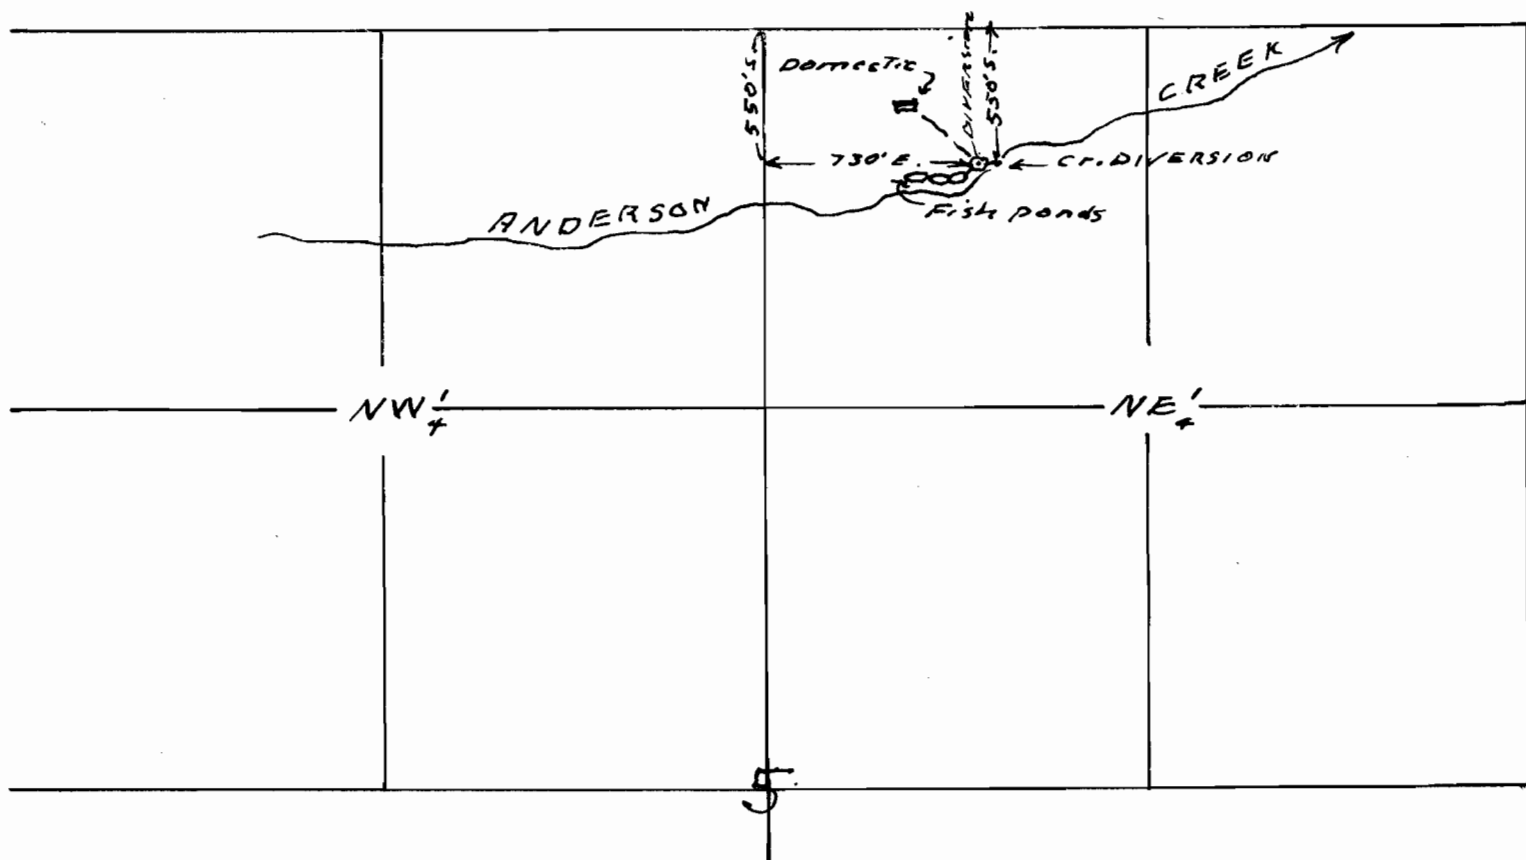

Map To accompany application of
S. B. Elrod for use of water from
Spring and Anderson Creek. for
domestic and fish propogation.

Application No. 26607
Permit No. 21012

This office 10/31/51 *W. Smith*