


T27 SR 2 W. 1/4 Sec 3 subdiv. NE 1/4 SW 1/4

Scale 4 inches = 1 Mile

November 12 1951.

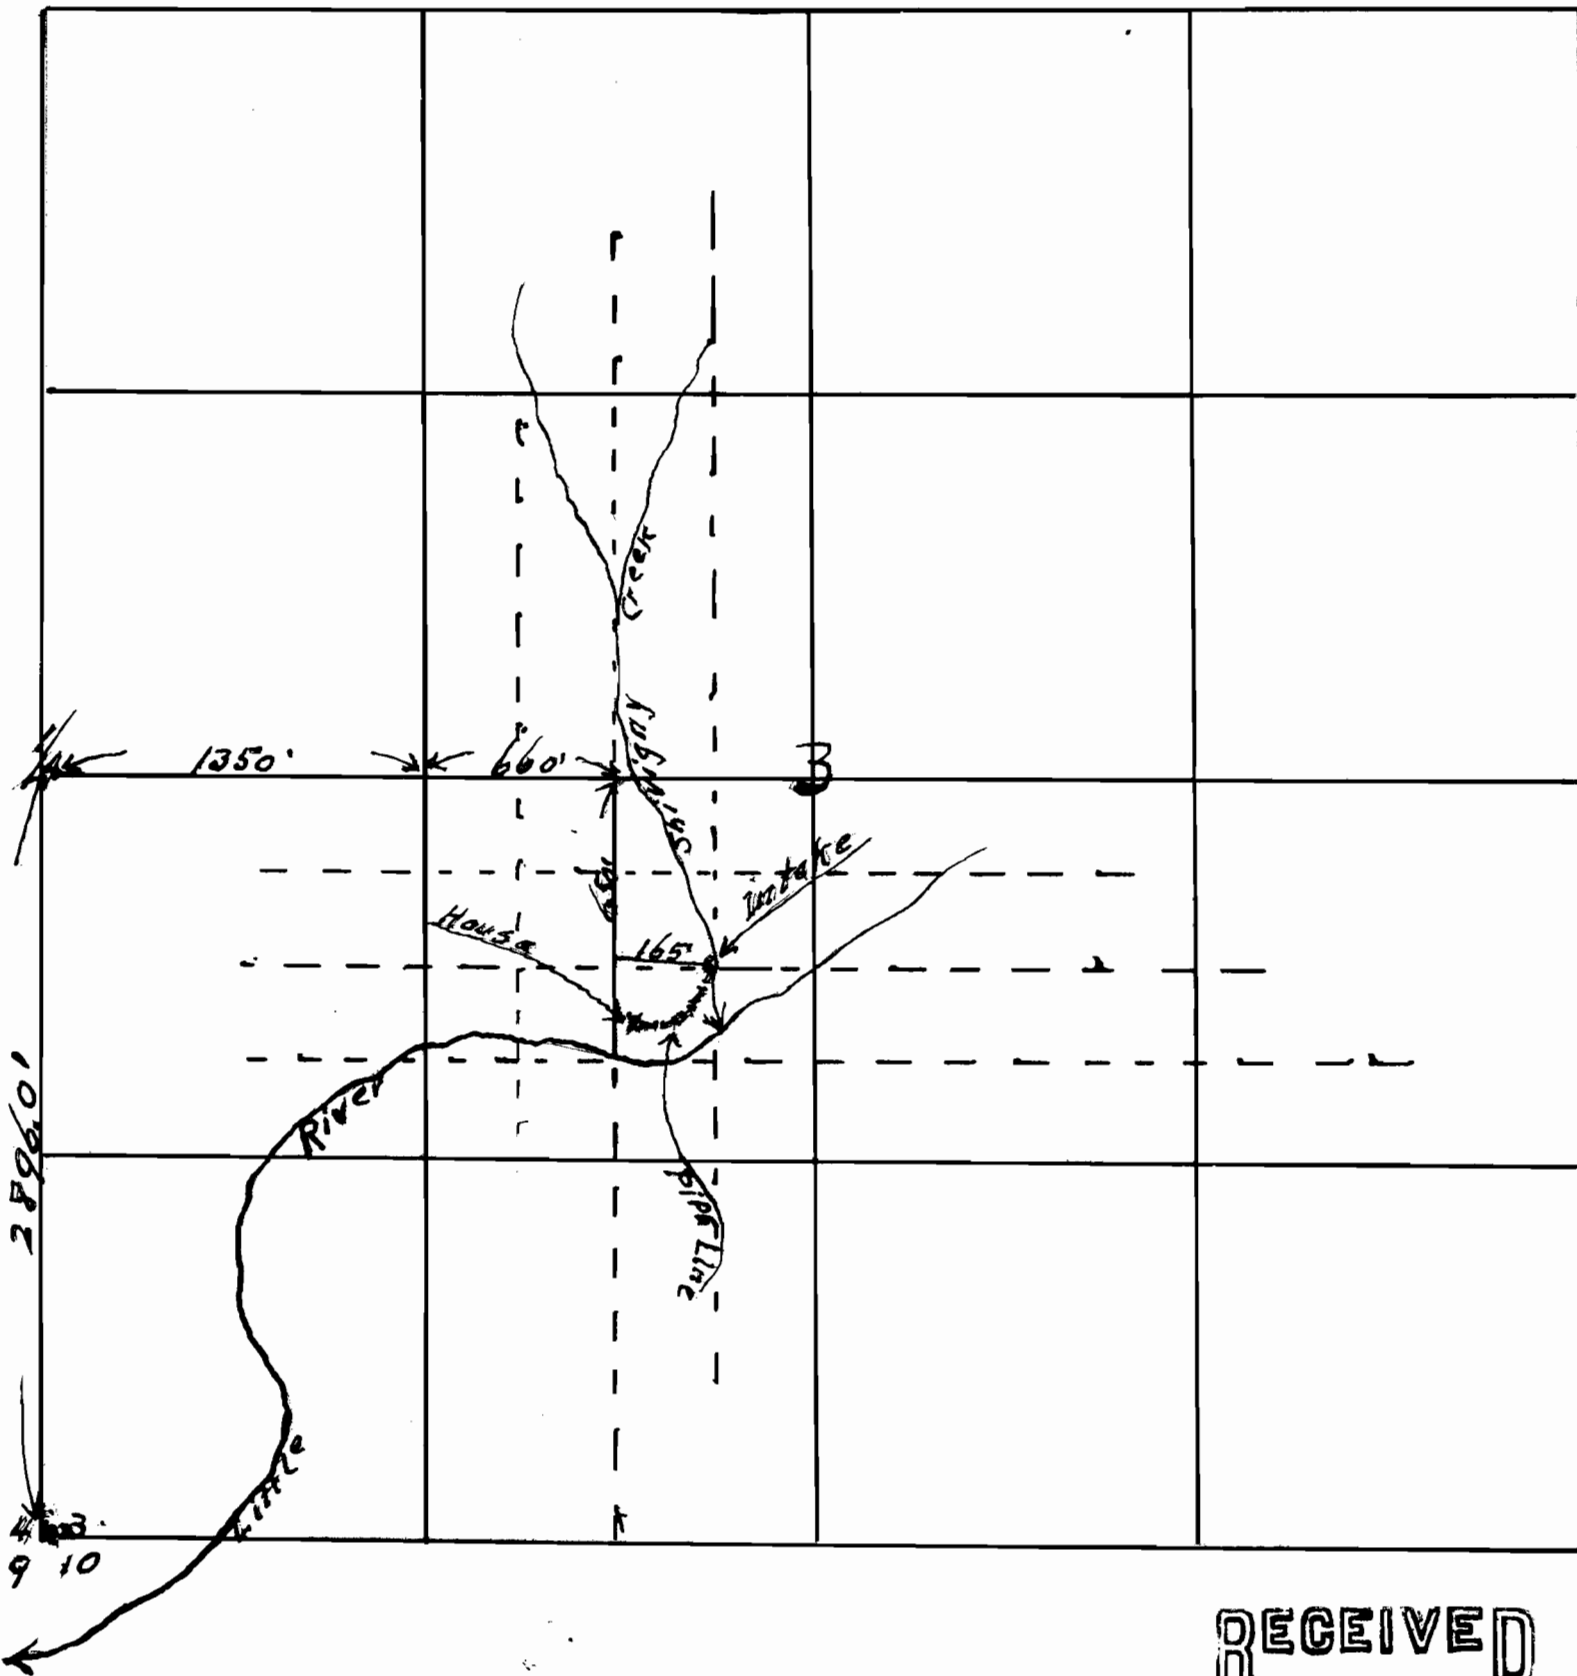

RECEIVED

NOV 27 1951

STATE ENGINEER  
SALEM, OREGON

Application No. 26668

Permit No. 21019