


0278

Township 37 South

Range 6 West

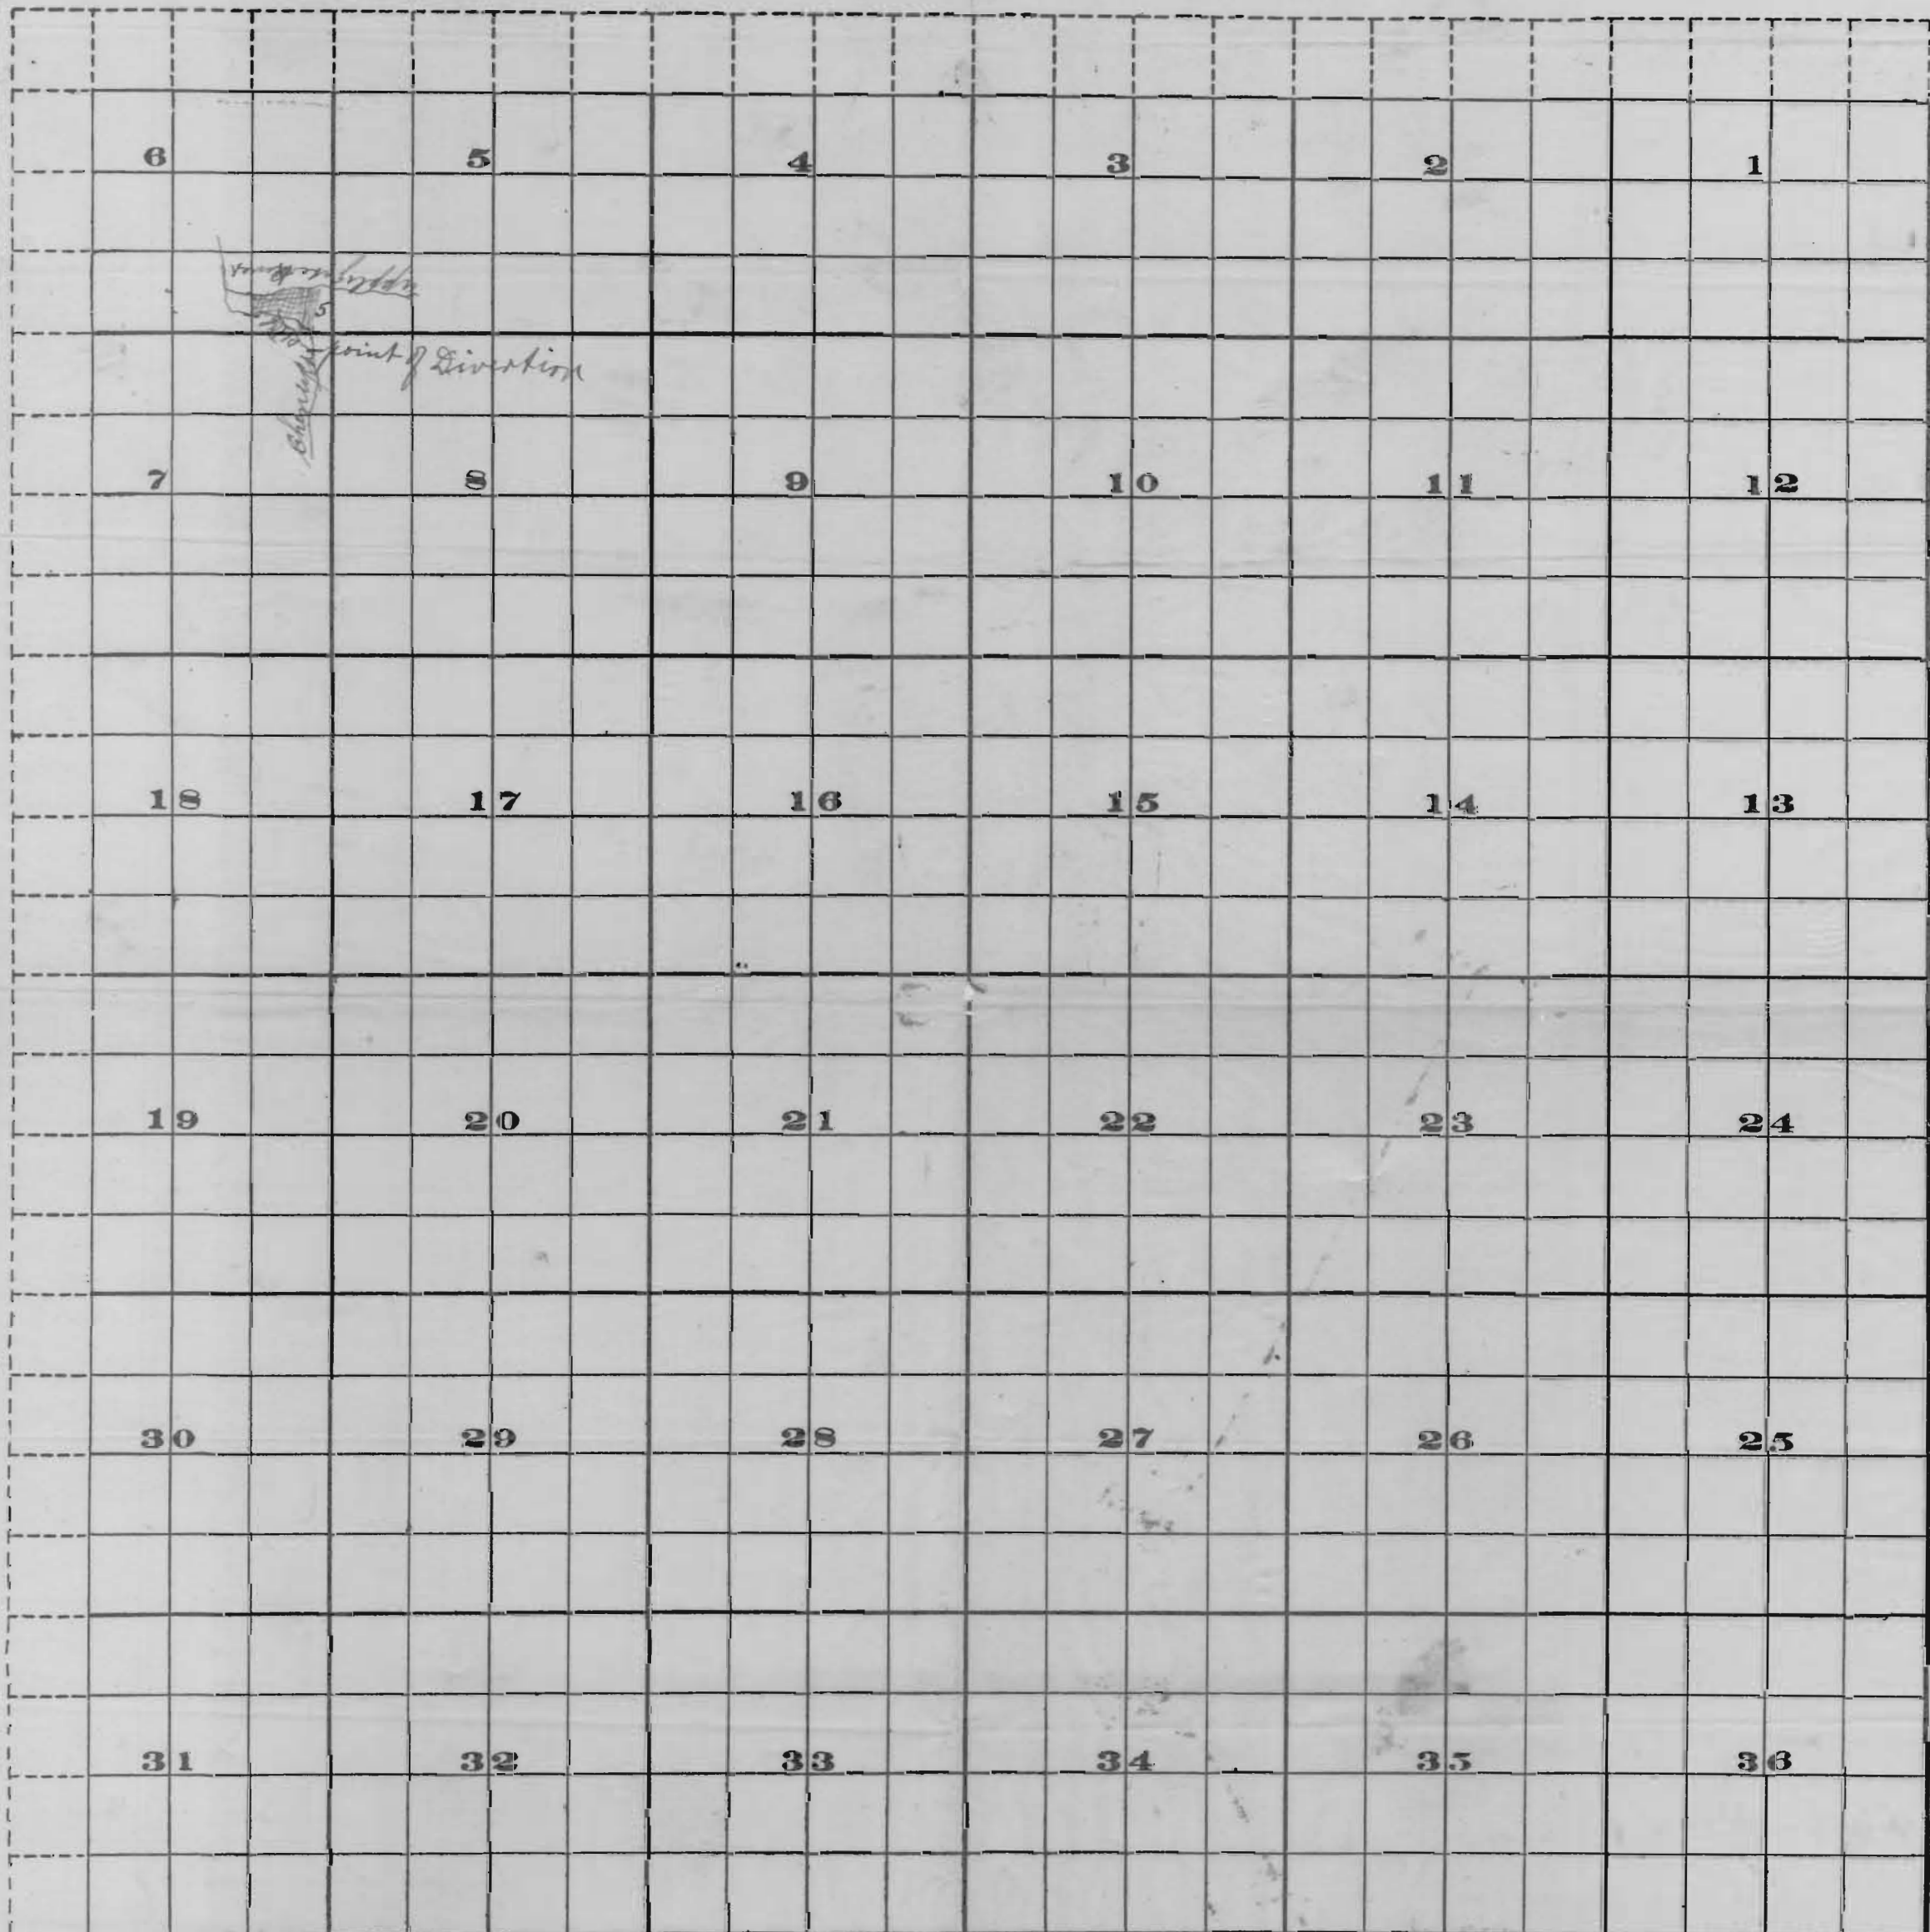

0278

0278

RECEIVED
JUL 22 1914
OFFICE OF STATE ENGINEER
SALEM, OREGON



Scale of Feet.

FROM OFFICE OF THE STATE ENGINEER, SALEM, OREGON

Application No. 3790
Permit No. 2109

OFFICE OF STATE ENGINEER
RECEIVED
JUL 22 1914
SALEM, OREGON

0278