


MAP

SHOWING
IRRIGATED LANDS and DITCHES
 UNDER STATE ENGINEERS PERMIT NO. 211
 Survey By Rhea Luper Oct. 14th and 15th
 1914

T₃₂S R₅W

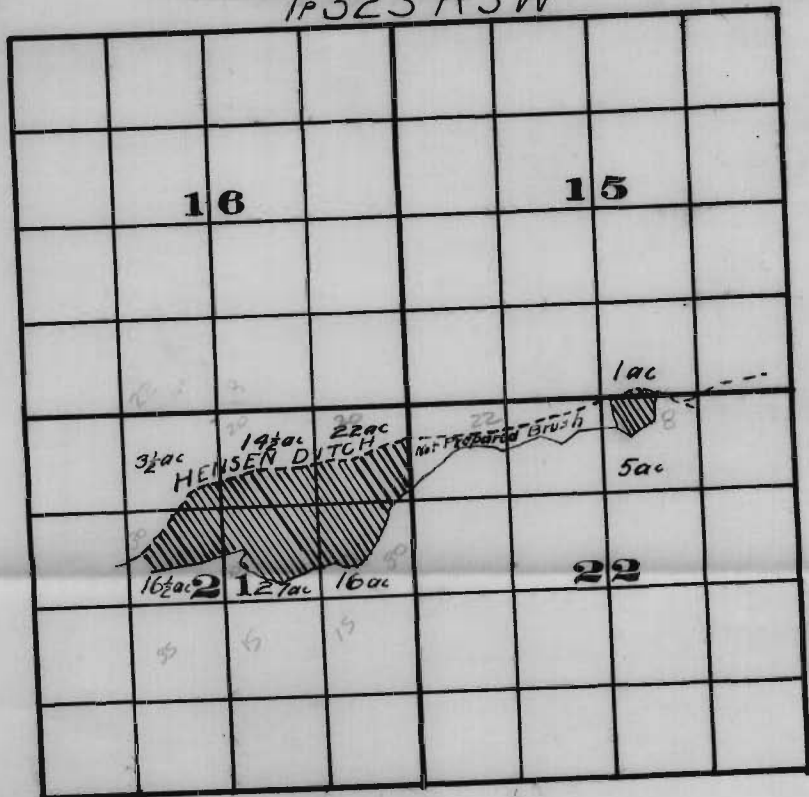

OFFICE OF STATE ENGINEERS
RECEIVED
 NOV 9 1914
 SALEM, OREGON,

Application No. 456
 Permit No. 211

H 2 P