


NW 1/4 SE 1/4 Sec. 20
 T. 32 S., R. 5 W., W. M.
 Scale 200' = 1" March 52

RECEIVED
 [Faint stamp text]

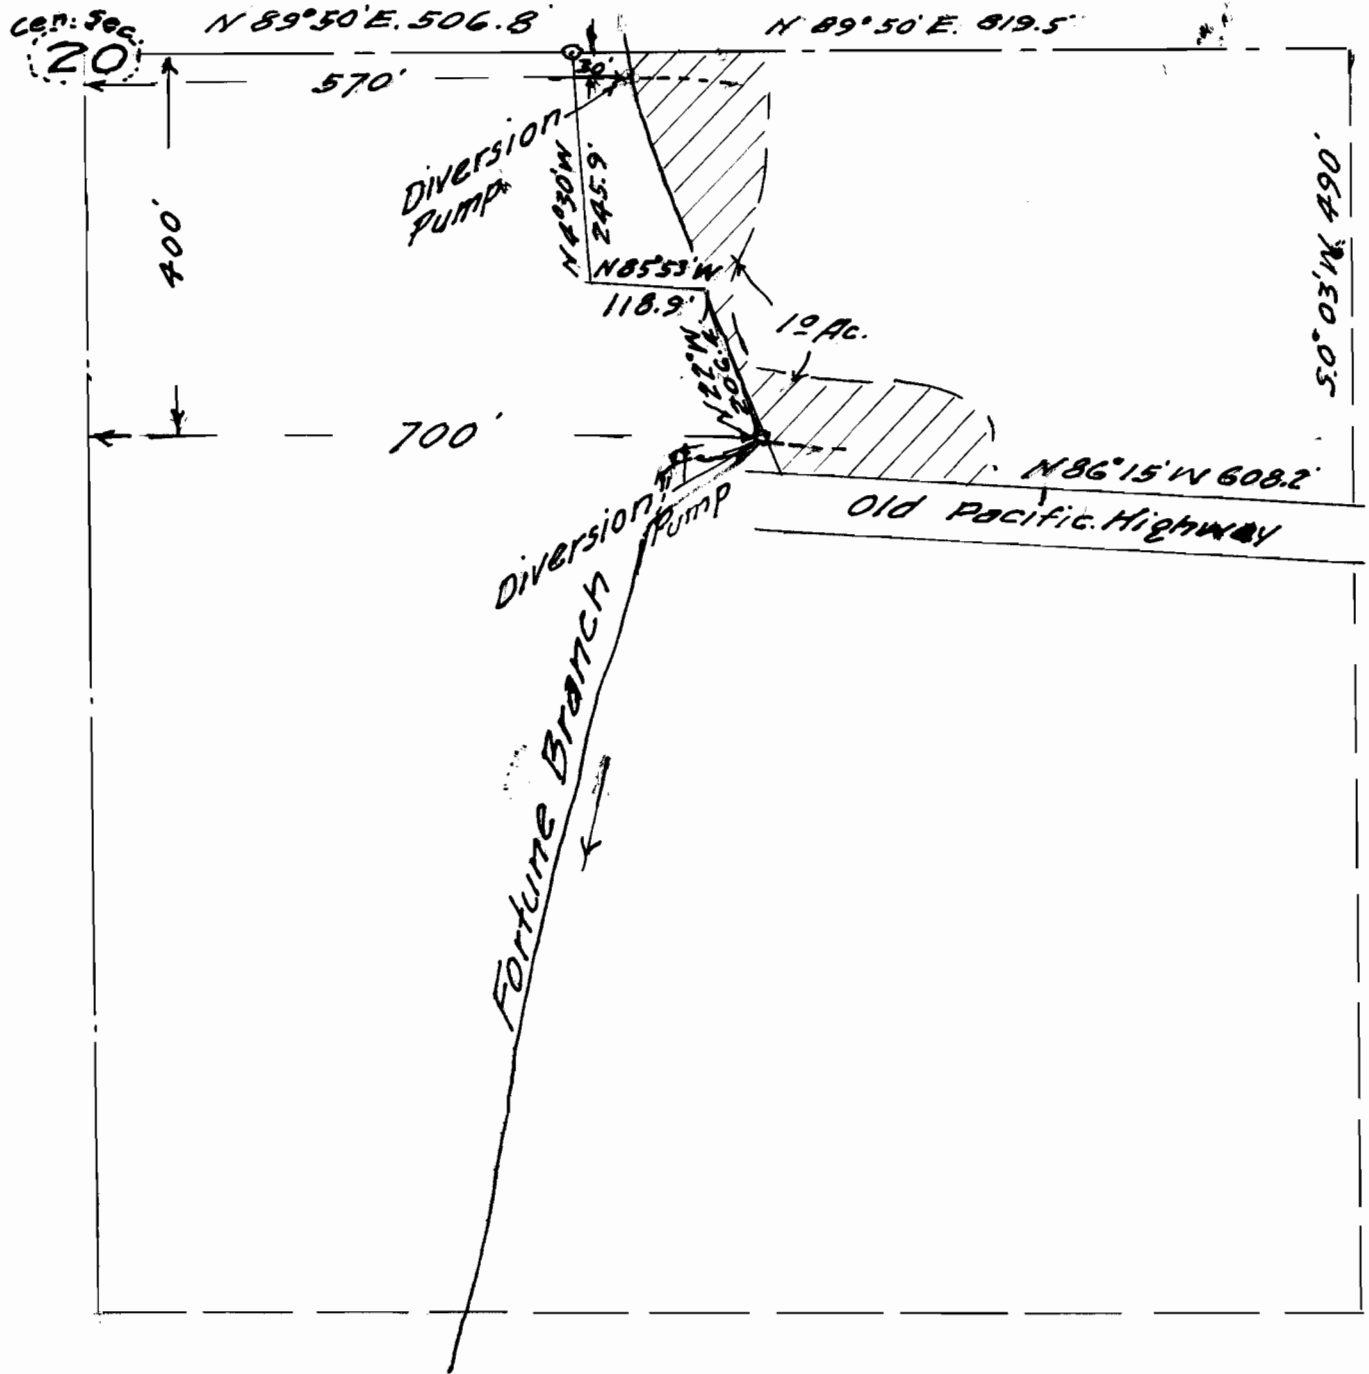

Edgar L. Nace

RECEIVED
 [Faint stamp text]

Application No. 26923
 Permit No. 21154