

Permit: S 21173
Volume: 1
Strm: ROGUE R
Trib: PACIFIC OCEAN
Priority: 3/12/52


T. 36 S. R. 5 W. W.M.

Scale 200' = 1"

March 1952

0.18095

3-12-52

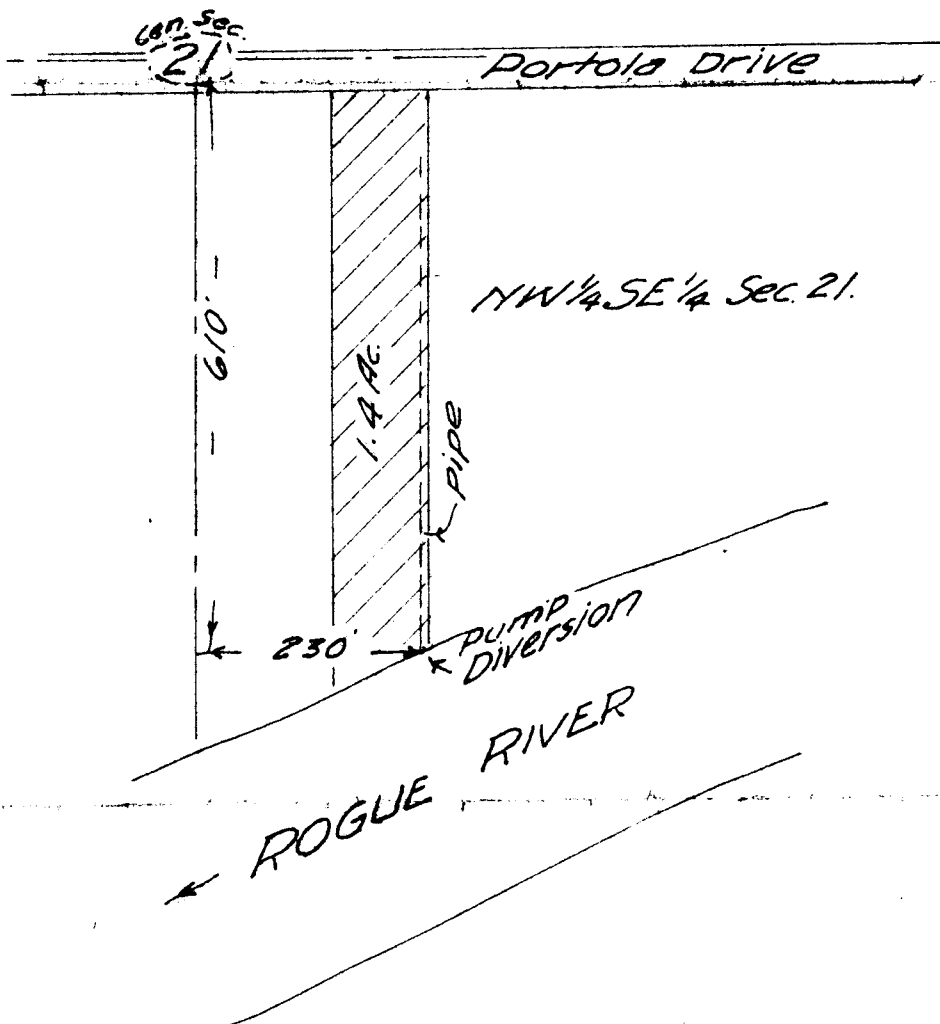

Larry C. Adams.

Registration No. 26951
Permit No. 21173

26951