

T.36S.R.11E.W.M.

FINAL PROOF SURVEY
UNDER

Application No. U-240, Permit No. U-216

IN NAME OF

CHARLES E. DREW & SON

Surveyed MAY 22 1951, by H.L. COFFMAN

NO.S 1,3,4 & 5 ARTESIAN WELLS


200-13



17

16

15

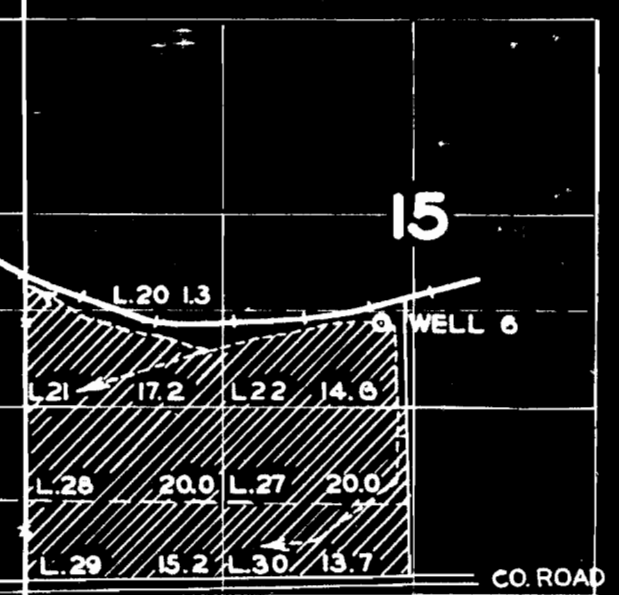

CO. ROAD