



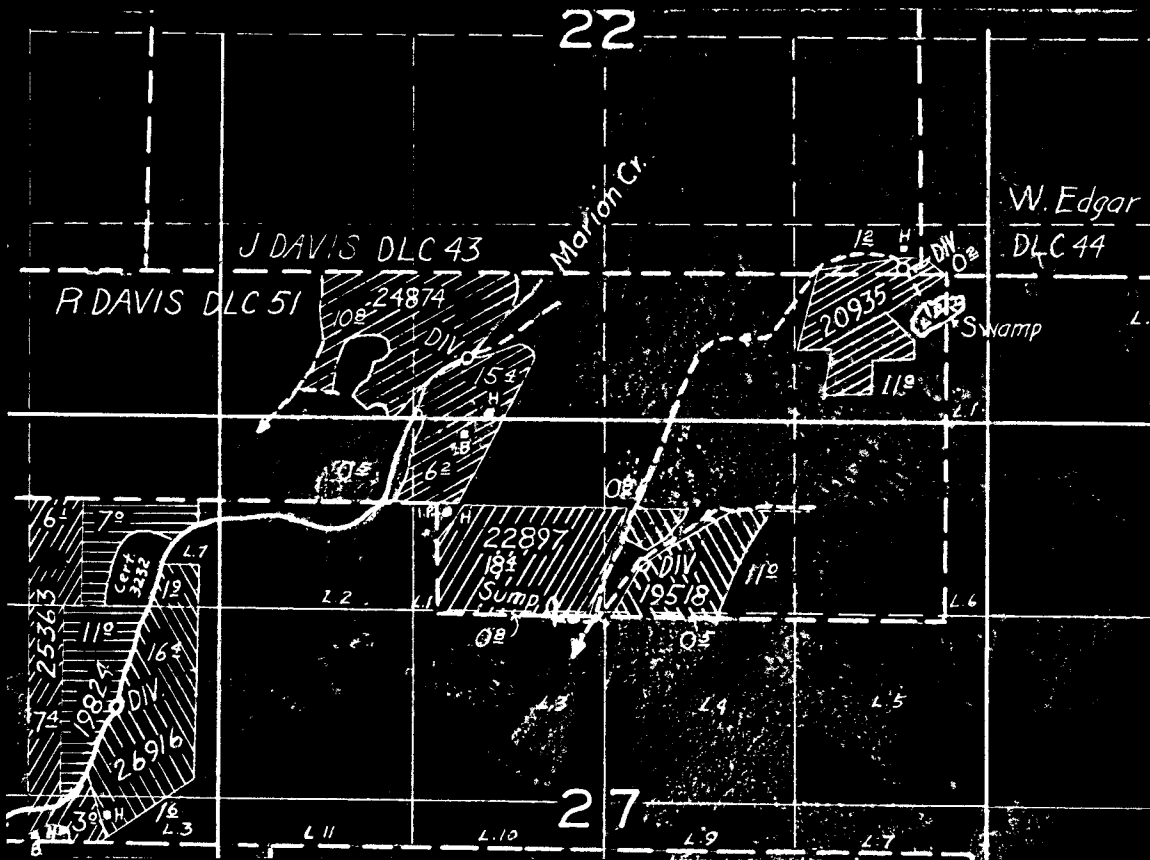

FINAL PROOF SURVEY

