


T. 37 S., R. 5 W., W. M.

Scale 4" = 1 Mile

May 1952

D. J. Willson
by Clifford Willson, Agent.

5 1952

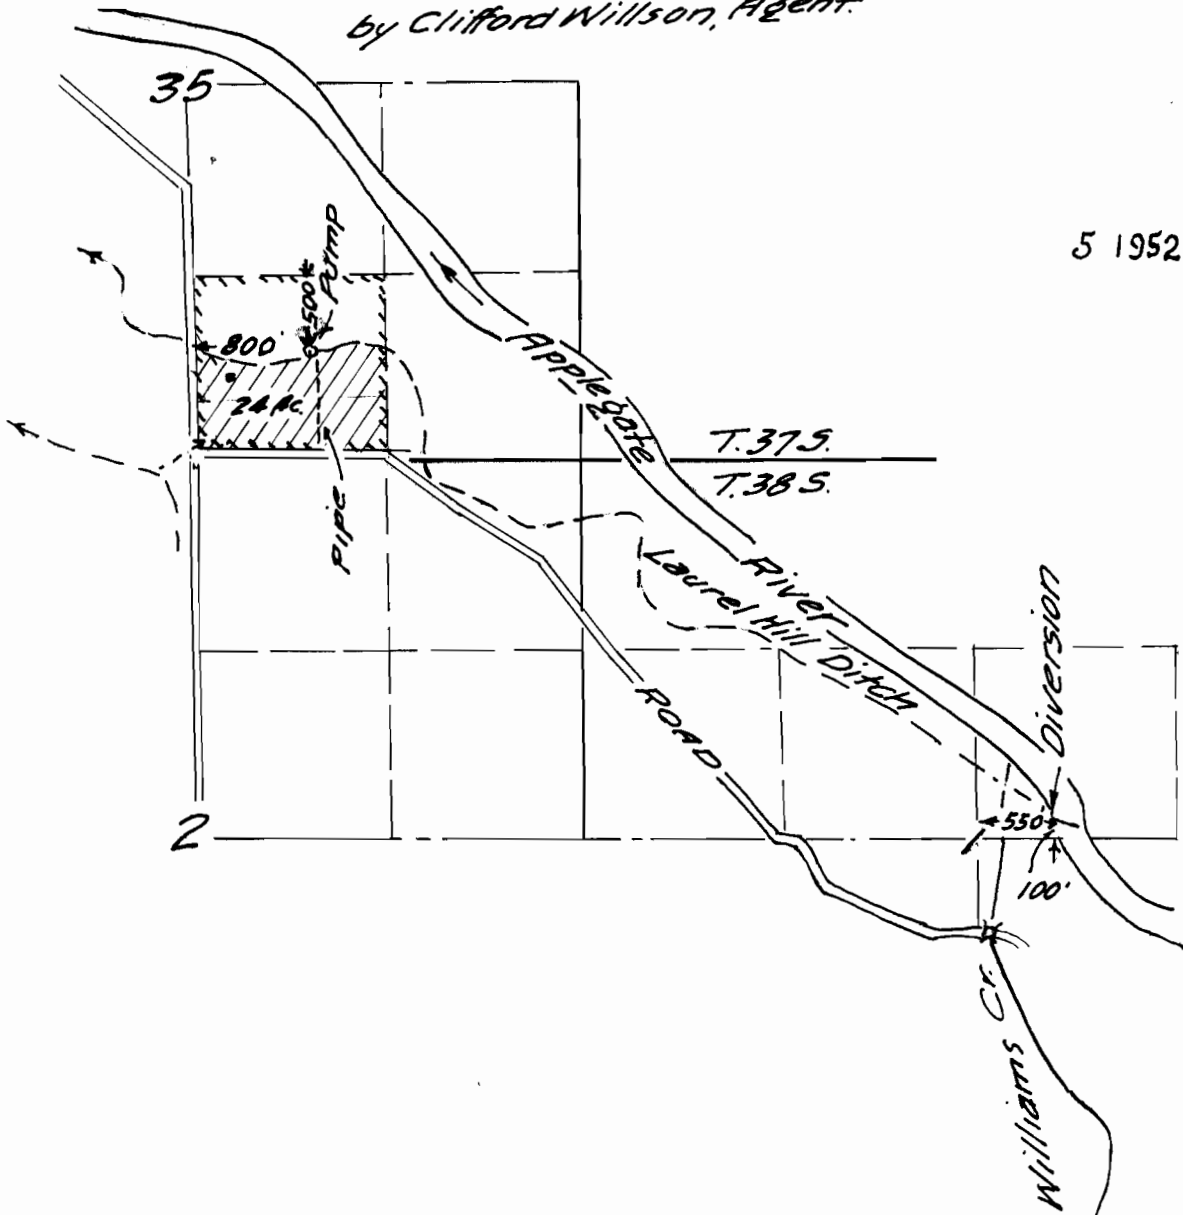

Application No. 27139
Permit No. 21347