


Township 11 S, Range 15 E.W.M.

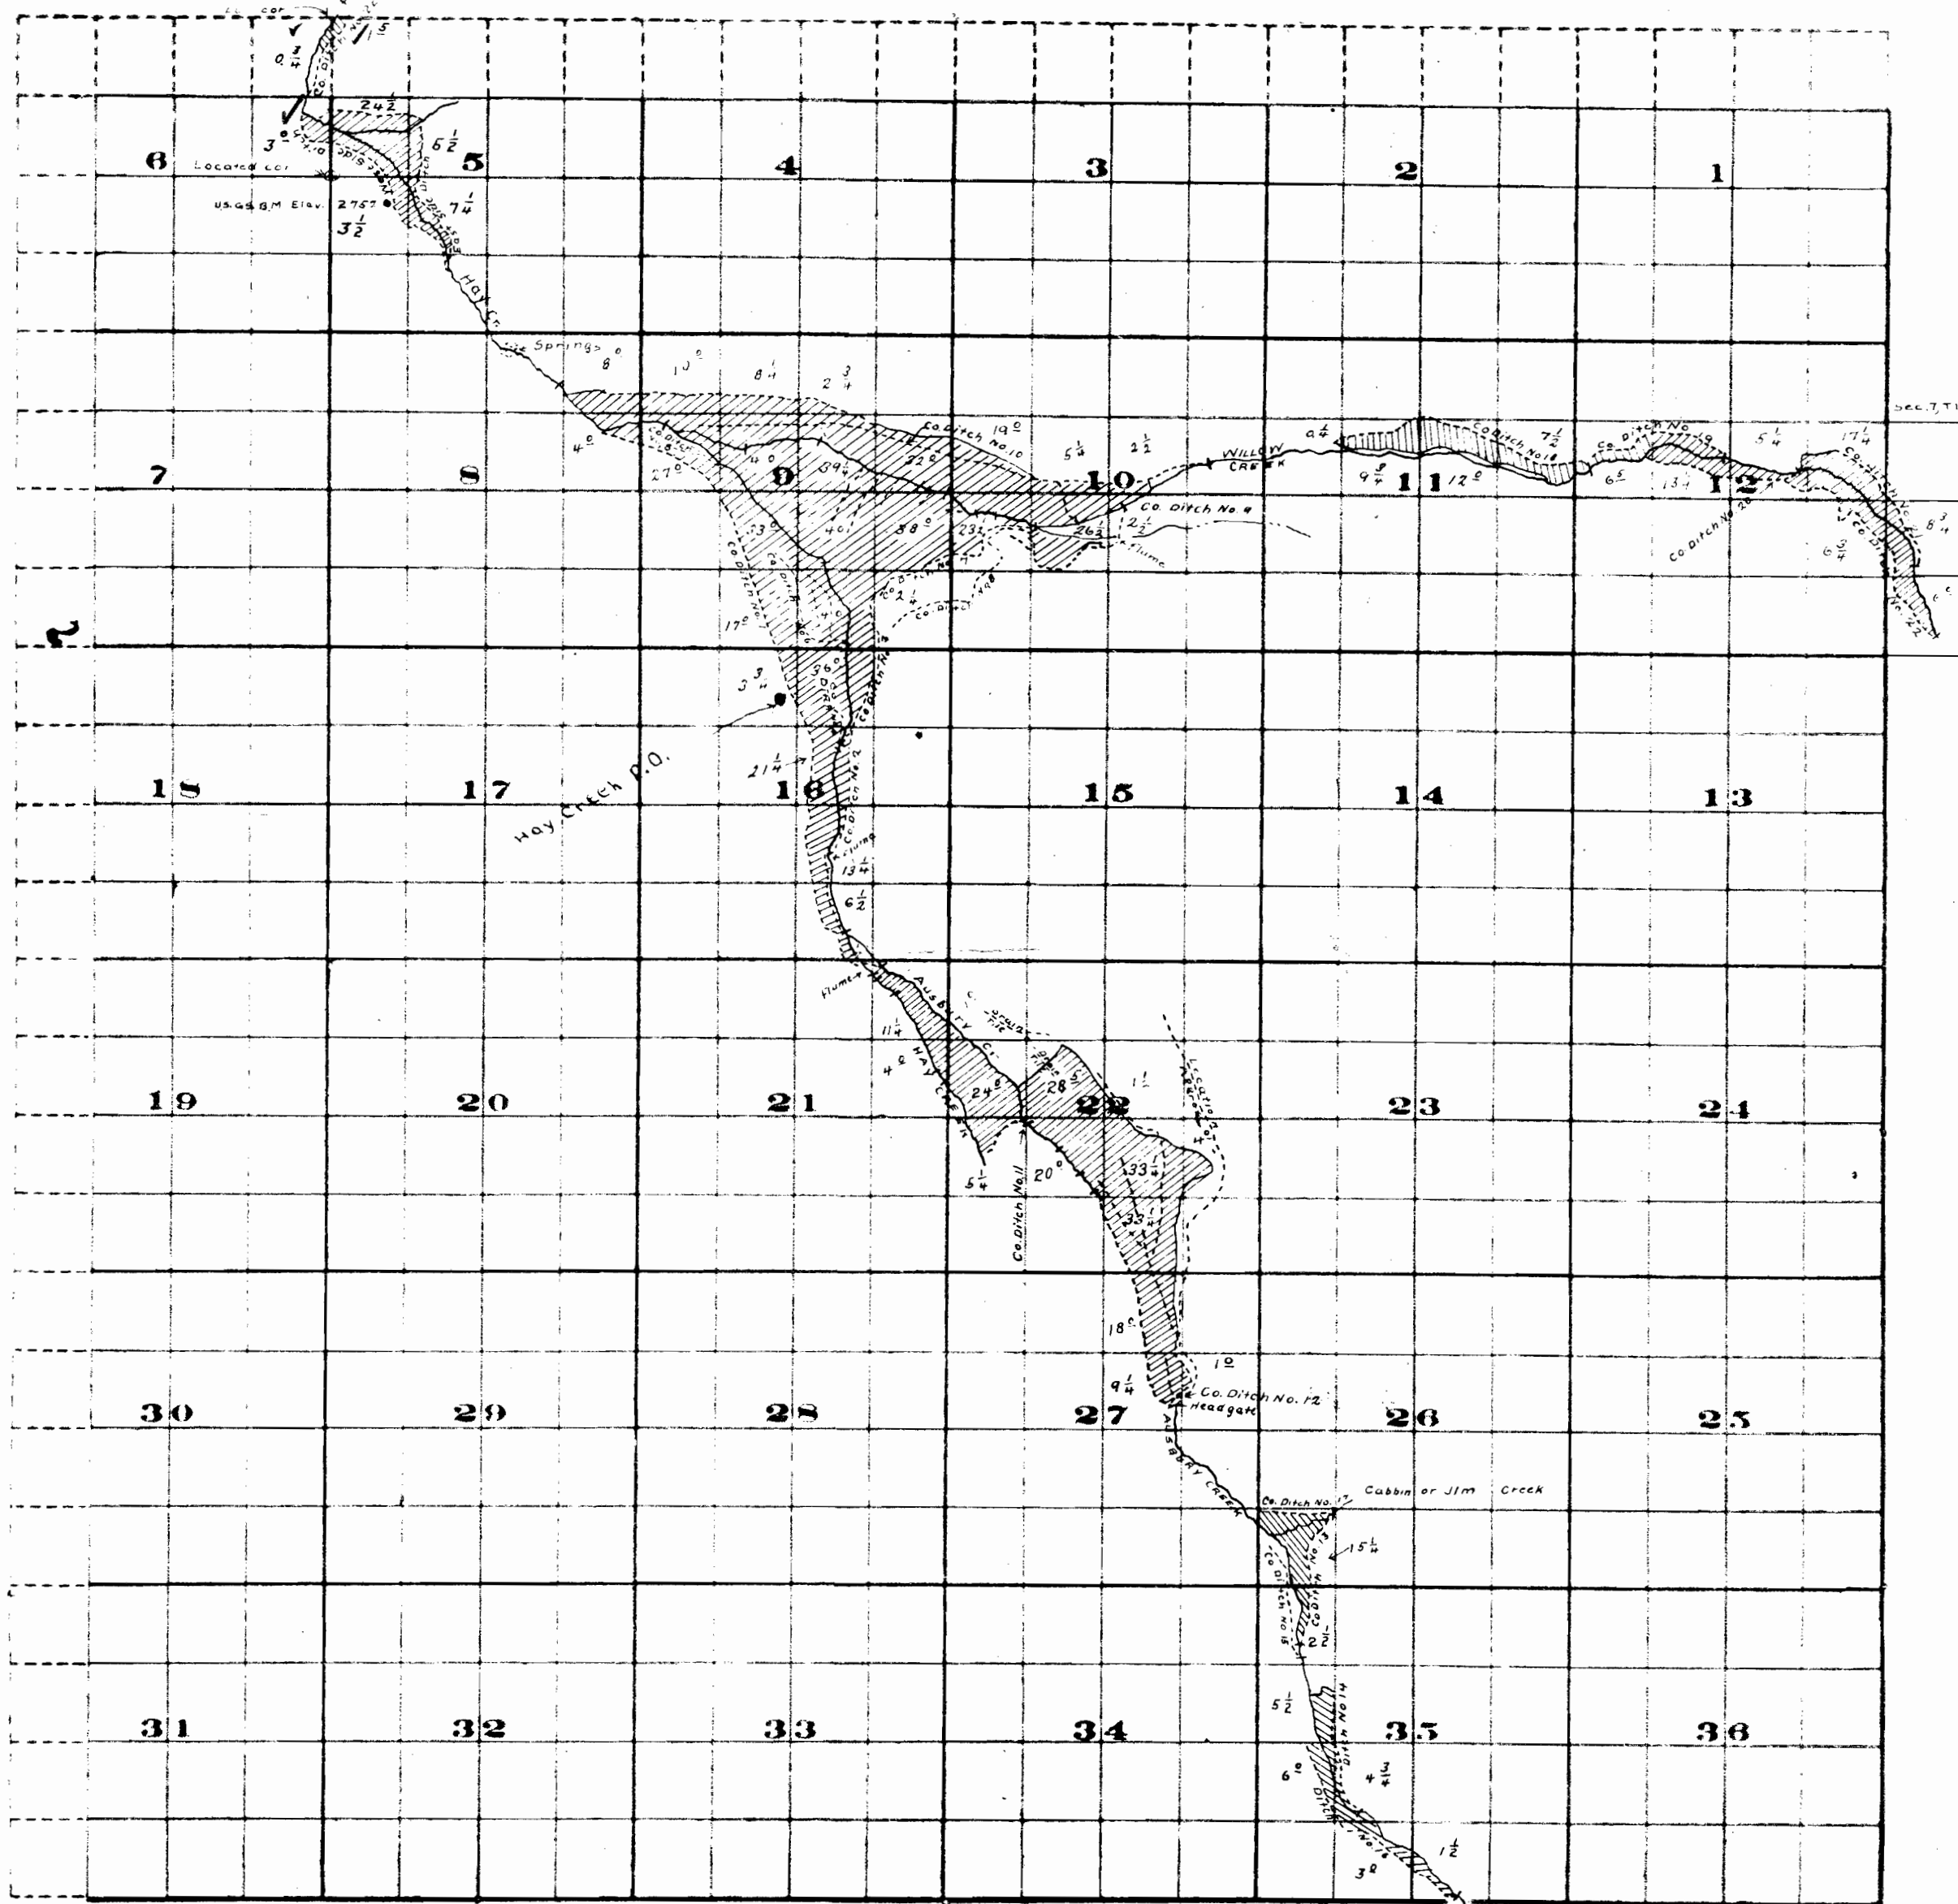

Survey Sept. 17-23, 1915

FROM OFFICE OF THE STATE ENGINEER, SALEM, OREGON

- LEGEND**
- Irrigated land with areas
 - Streams
 - Ditches
 - Dams

Scale of Feet


DO NOT SEND OUT
OF OFFICE OF STATE
ENGINEER

Adjudication Survey
Trout Creek
and
Tributaries

App. No.
Permit No.

APP. NO. 26226
 R-26226
 26226
 R-1333
 21403

Township 10 S, Range 15 E.W.M.

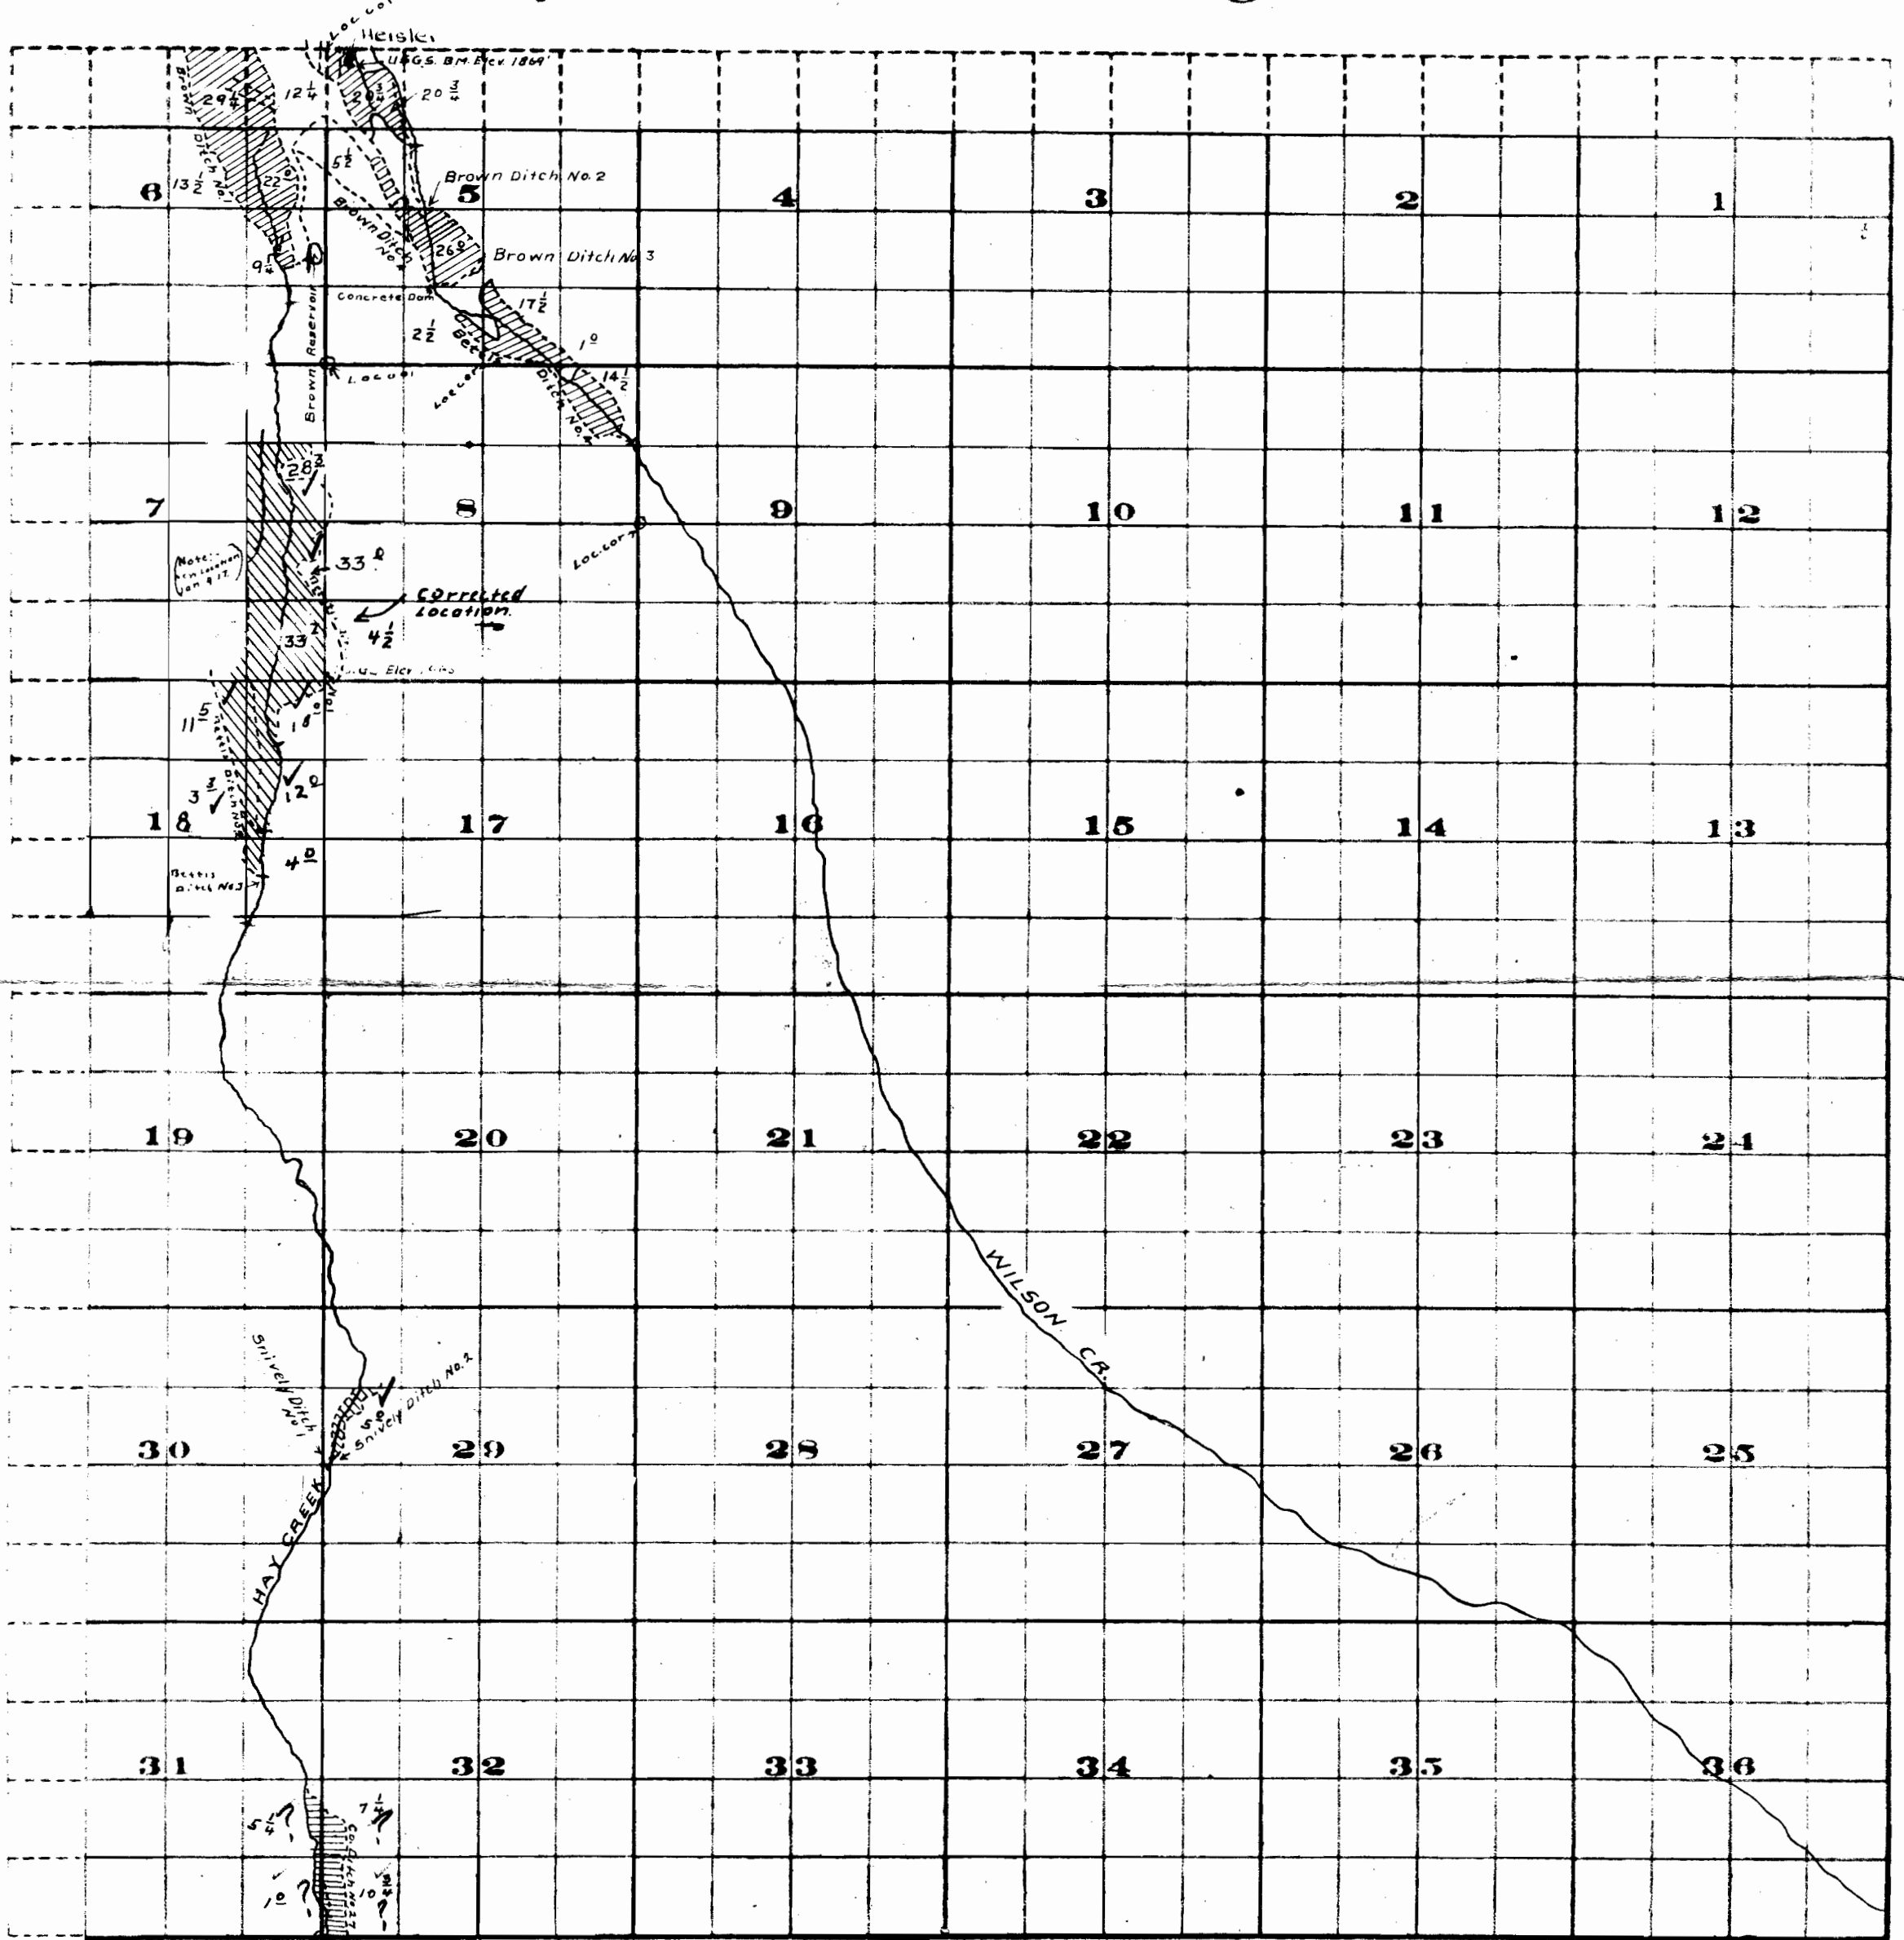

Capacity of Brown Res. 40 ac. ft.

Loc. cor. Only one cor. found

Survey Sept 21-23, 1915

FROM OFFICE OF THE STATE ENGINEER, SALEM, OREGON

Adjudication Survey
Trout Creek
and
Tributaries

- LEGEND**
-  Irrigated land with area
 -  Streams
 -  Ditches

Scale of Feet

**DO NOT SEND OUT
OF OFFICE OF STATE
ENGINEER**

APP No. 26226
LITTLE WILLOW

App. No.
Form No.

R-26225
26226
R-1333
21403

