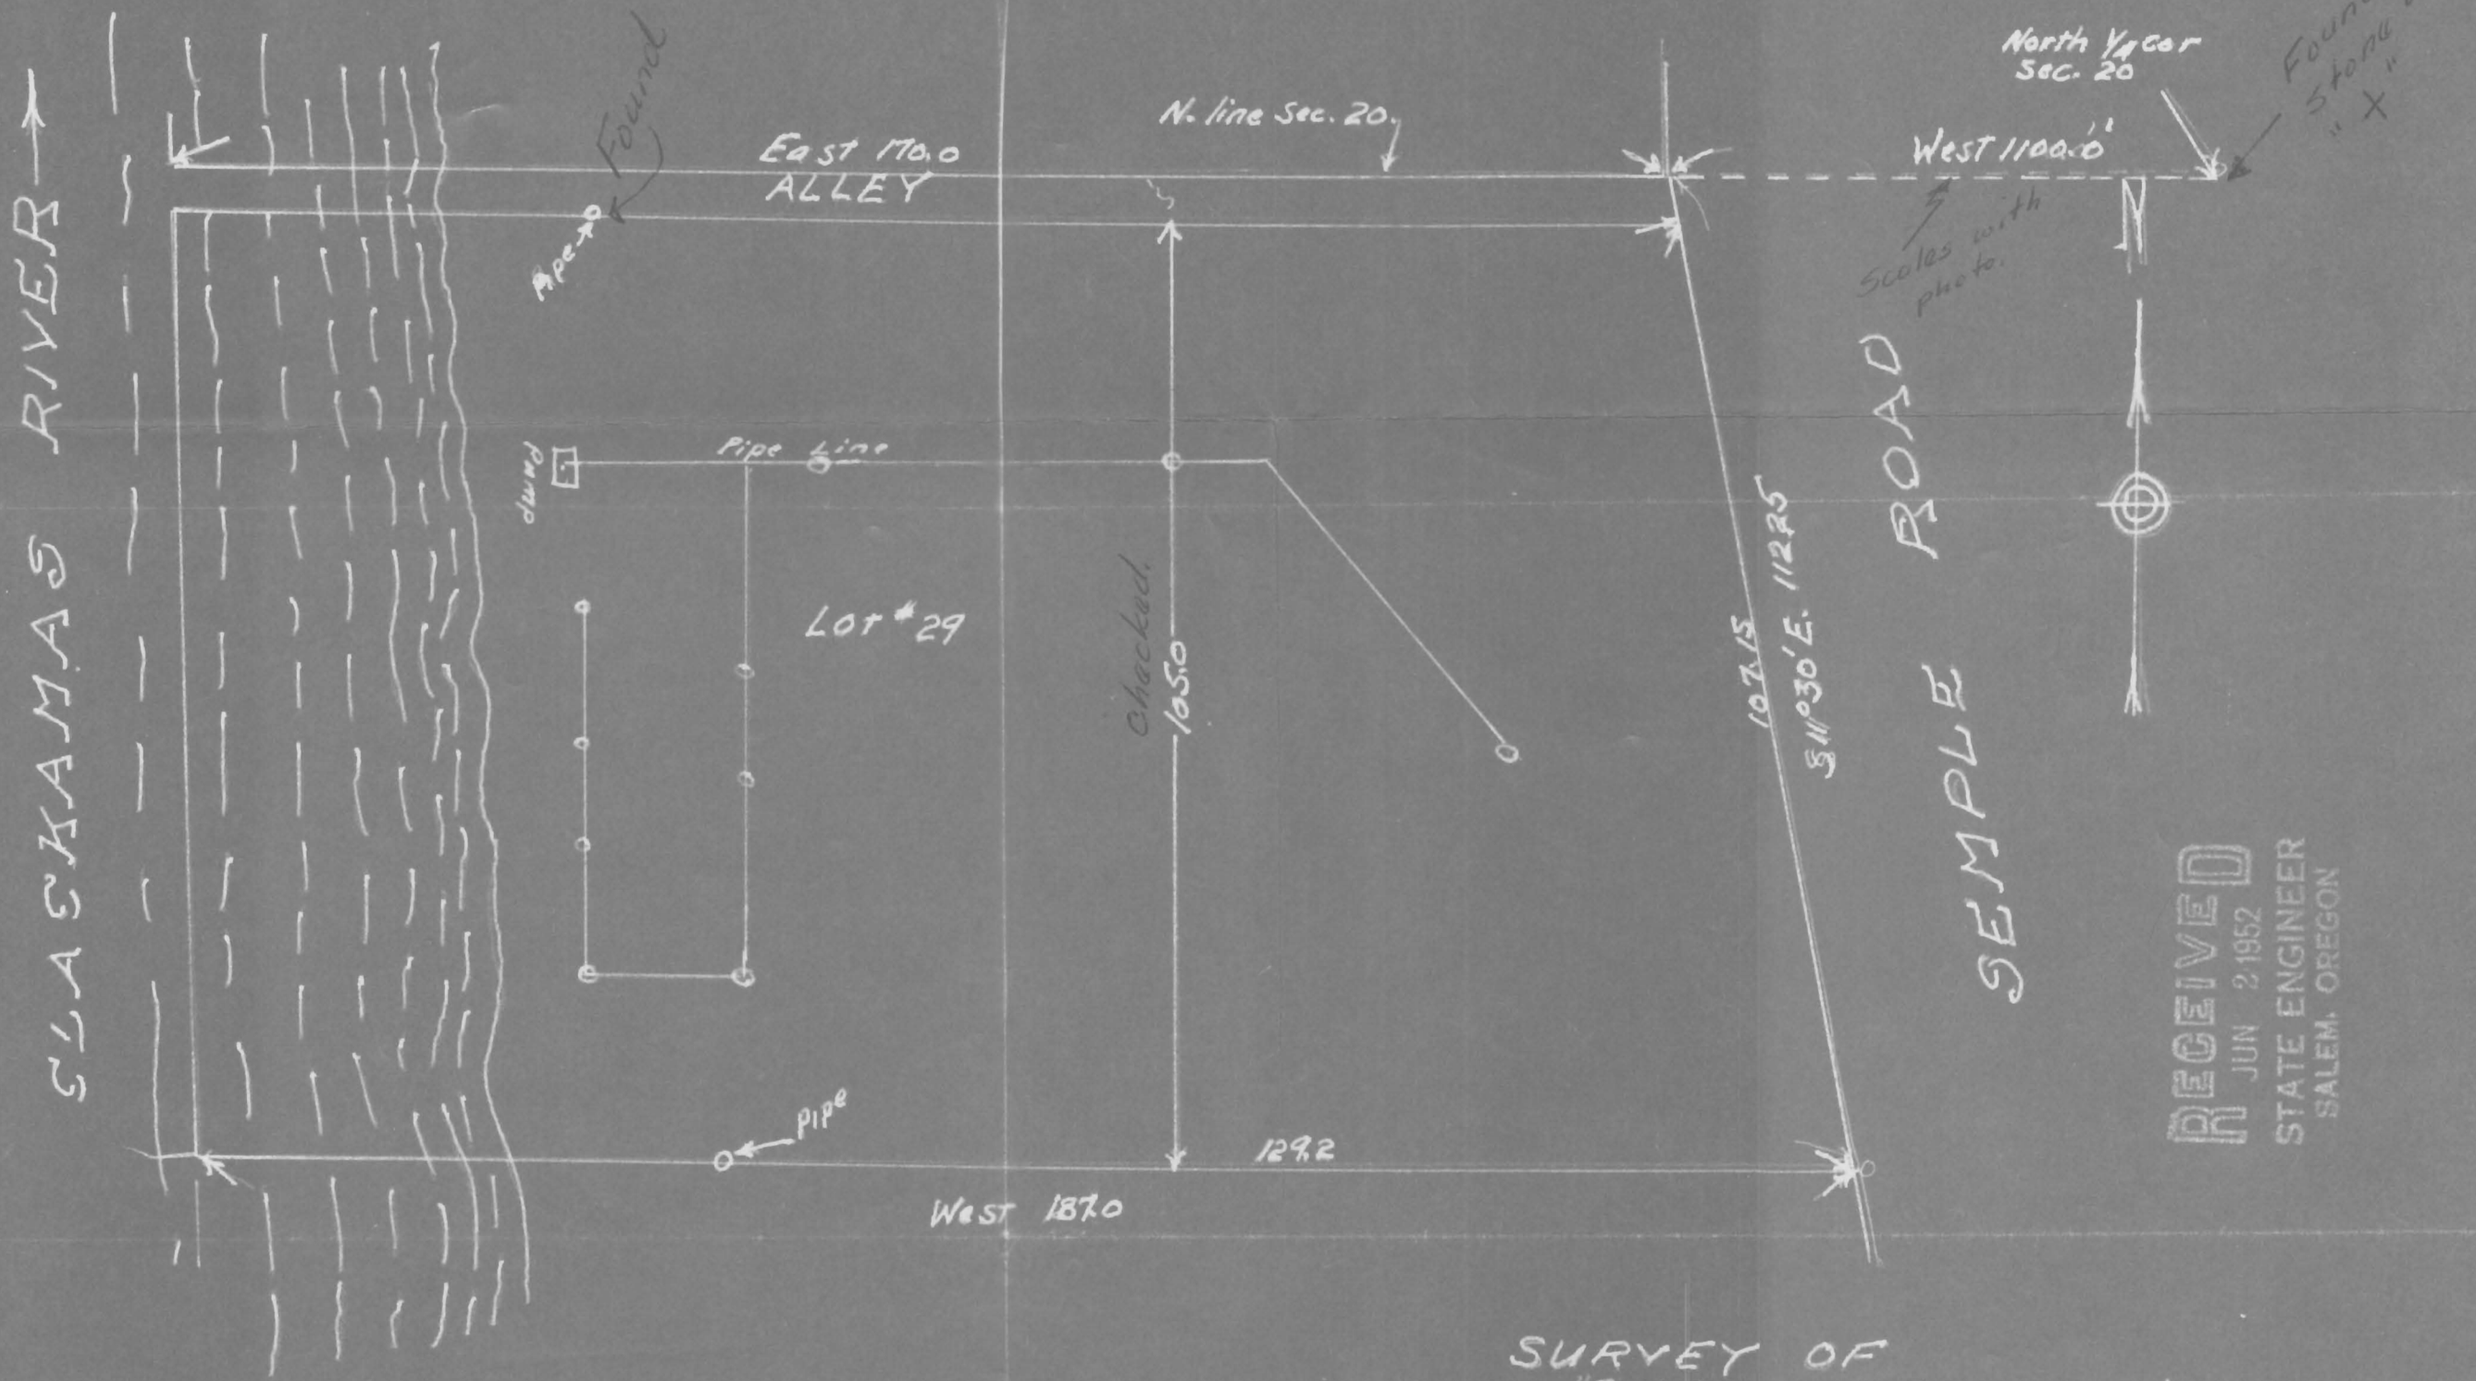

RECEIVED
JUN 2 1952
STATE ENGINEER
SALEM, OREGON

SURVEY OF
LOT 29 IN "RIVER PARK (UNRECORDED)
IN SEC. 20, T. 2 S, R. 3 E., W.M.
For C.L. Minahan
Oct. 1951 1" = 20'
Beasley & Stoehr, Civil Engrs.

Application No. 27260
Permit No. 21446