


Township 10 S

Range 15 E.W.M

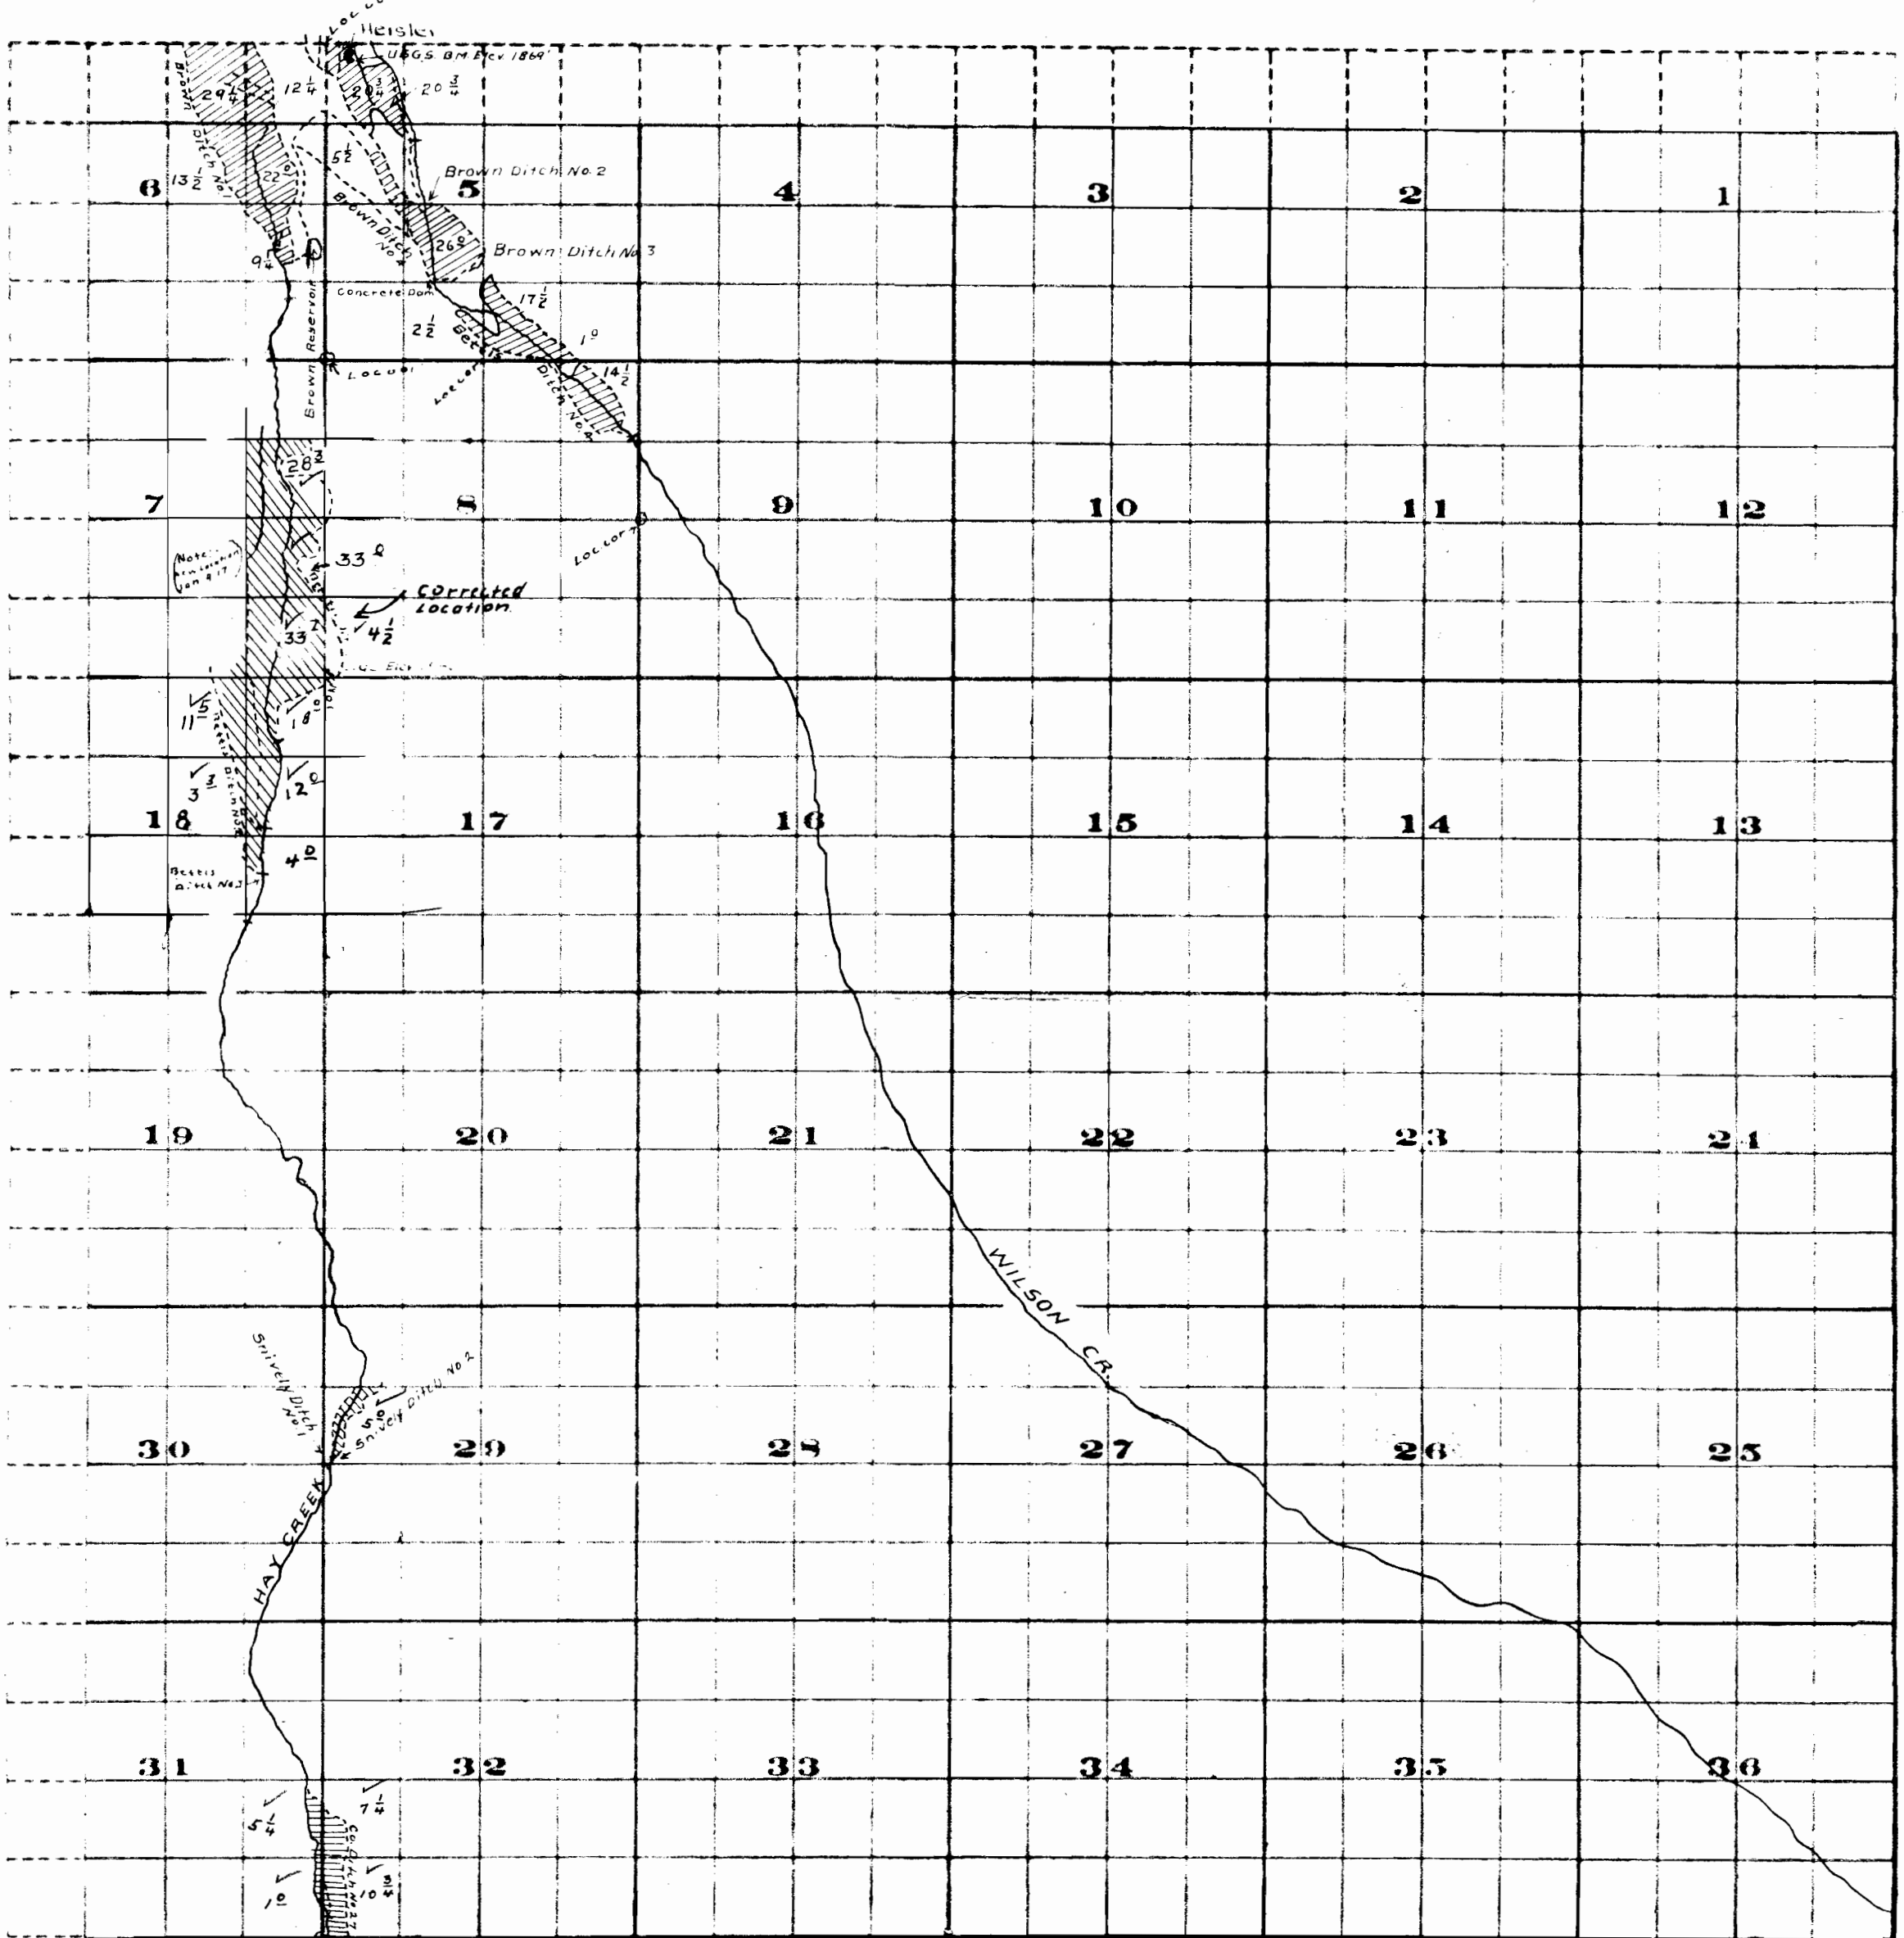

Loc cor. only one cor. found

Survey Sept 21-23, 1915

FROM OFFICE OF THE STATE ENGINEER, SALEM, OREGON

Adjudication Survey
Trout Creek
and
Tributaries

LEGEND *Scale of Feet*

Irrigated land with area

Streams

Ditches

**DO NOT SEND OUT
OF OFFICE OF STATE
ENGINEER**

26228

Ap. No. R-26227
 26228
 File No. R-1376
 21496