

G.L. RIDENOUR

SECTION 21 TWP. 13 S R 7 W WILL. MERIDIAN



Scale: 1 inch = 2 chains

June 17, 1952




Curtis C. Hanson

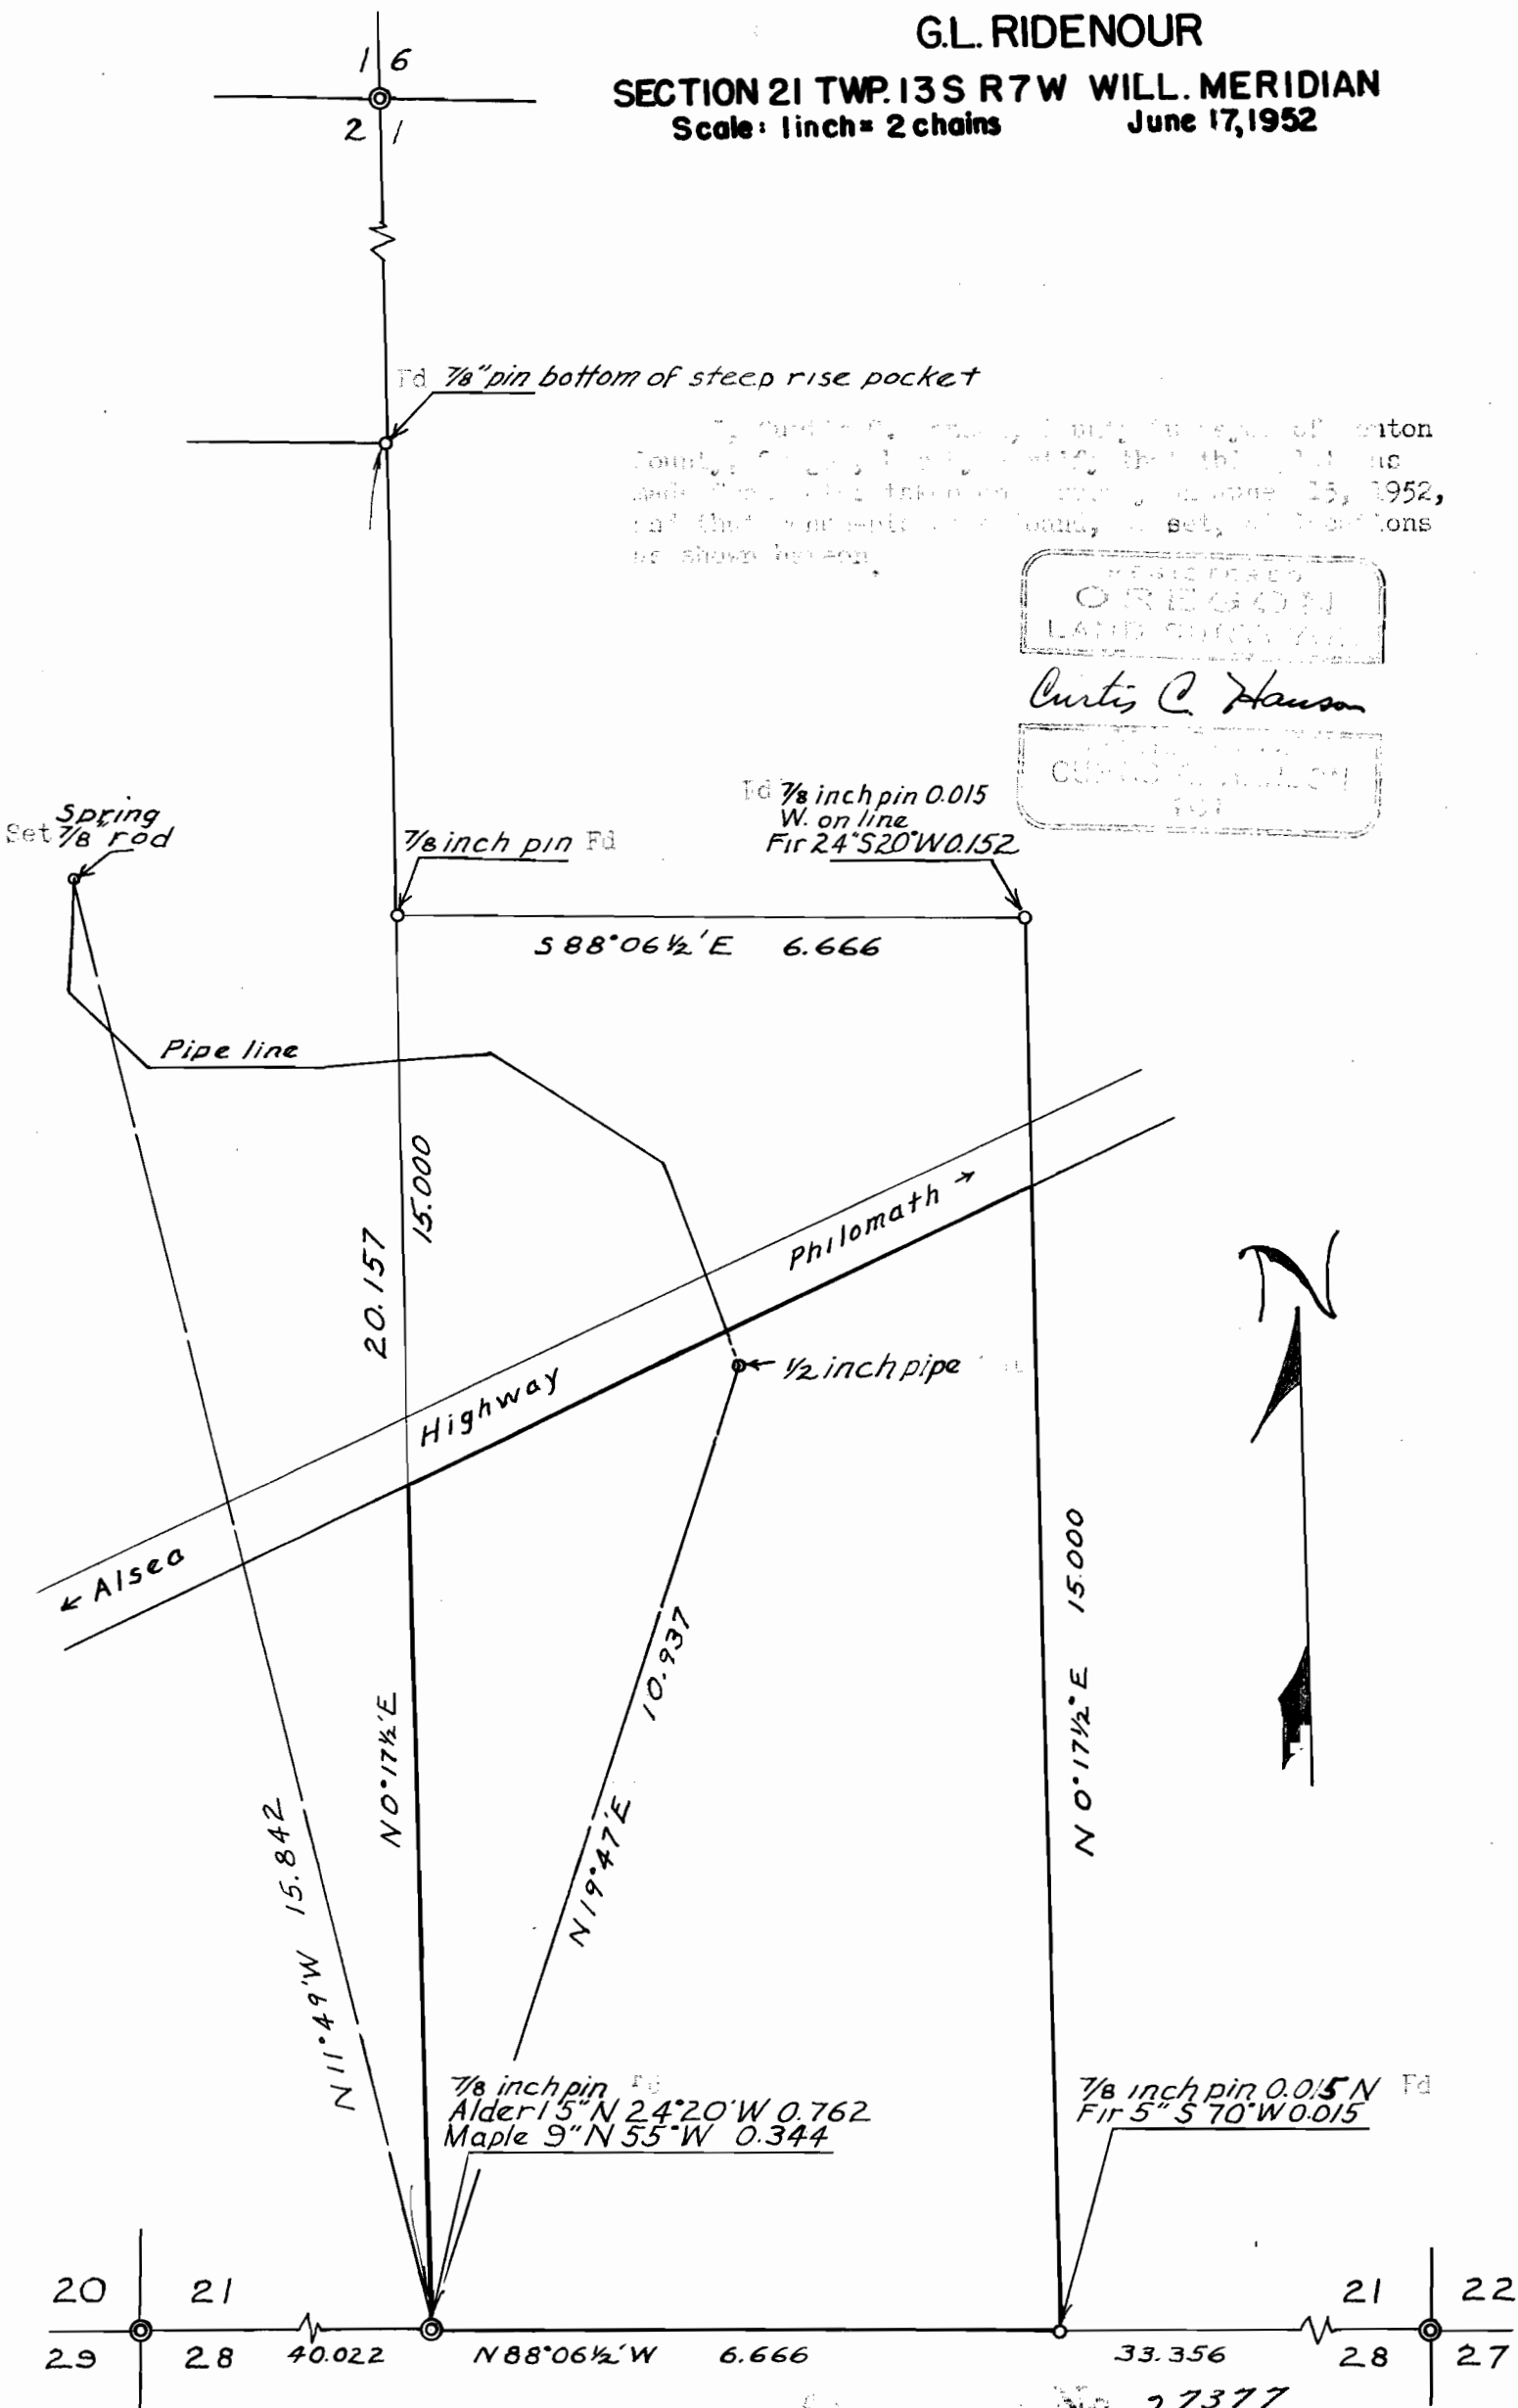 

No. 27377