


T 37 S R 9 W W M

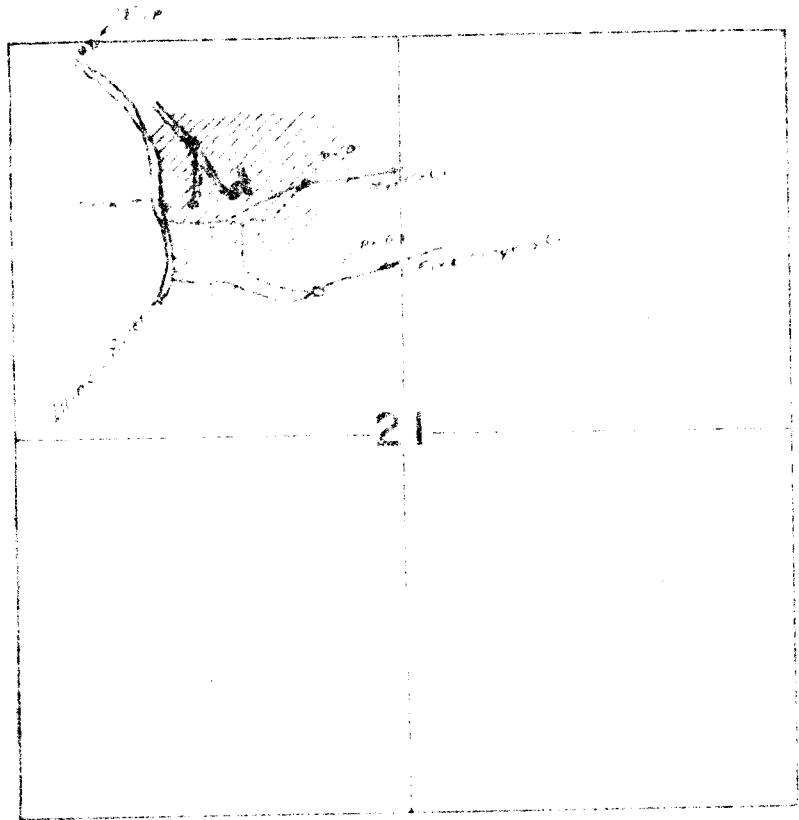

FINAL PROOF SURVEY

UNDER

Application No 27396 Permit No 21561
in name of
J. S. Gallaher

Surveyed Oct 20, 1909 by [illegible]