


Plat of
 The Rod Newcome Acreage
 in the Stewart Hanna Donation Land Claim
 in Sections 8th & 17; Twp. 4 S; R. 3 W; W.M.
 compiled from Aerial Photo and County Assessors Records
 By M.H.Kraft Tax Lot 1743-338

Scale 1" = 400'

-N-

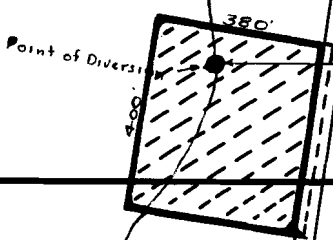

2000 ±

8 9
 17 16

Application No. 27475
 Permit No. 1880