


# T. 10 S., R. 10 W. W.M.

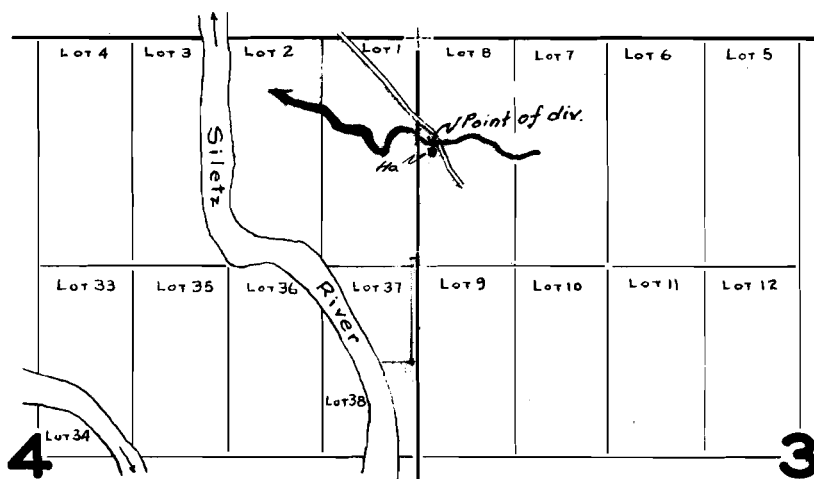

Application No. 27480 Permit No. 21631  
IN NAME OF