


RECEIVED
NOV 19 1952
STATE ENGINEER

T. 36 S., R. 6 W., W. 17.

Scale 400' = 1" Nov. 1952.

Howard M. Knapp.

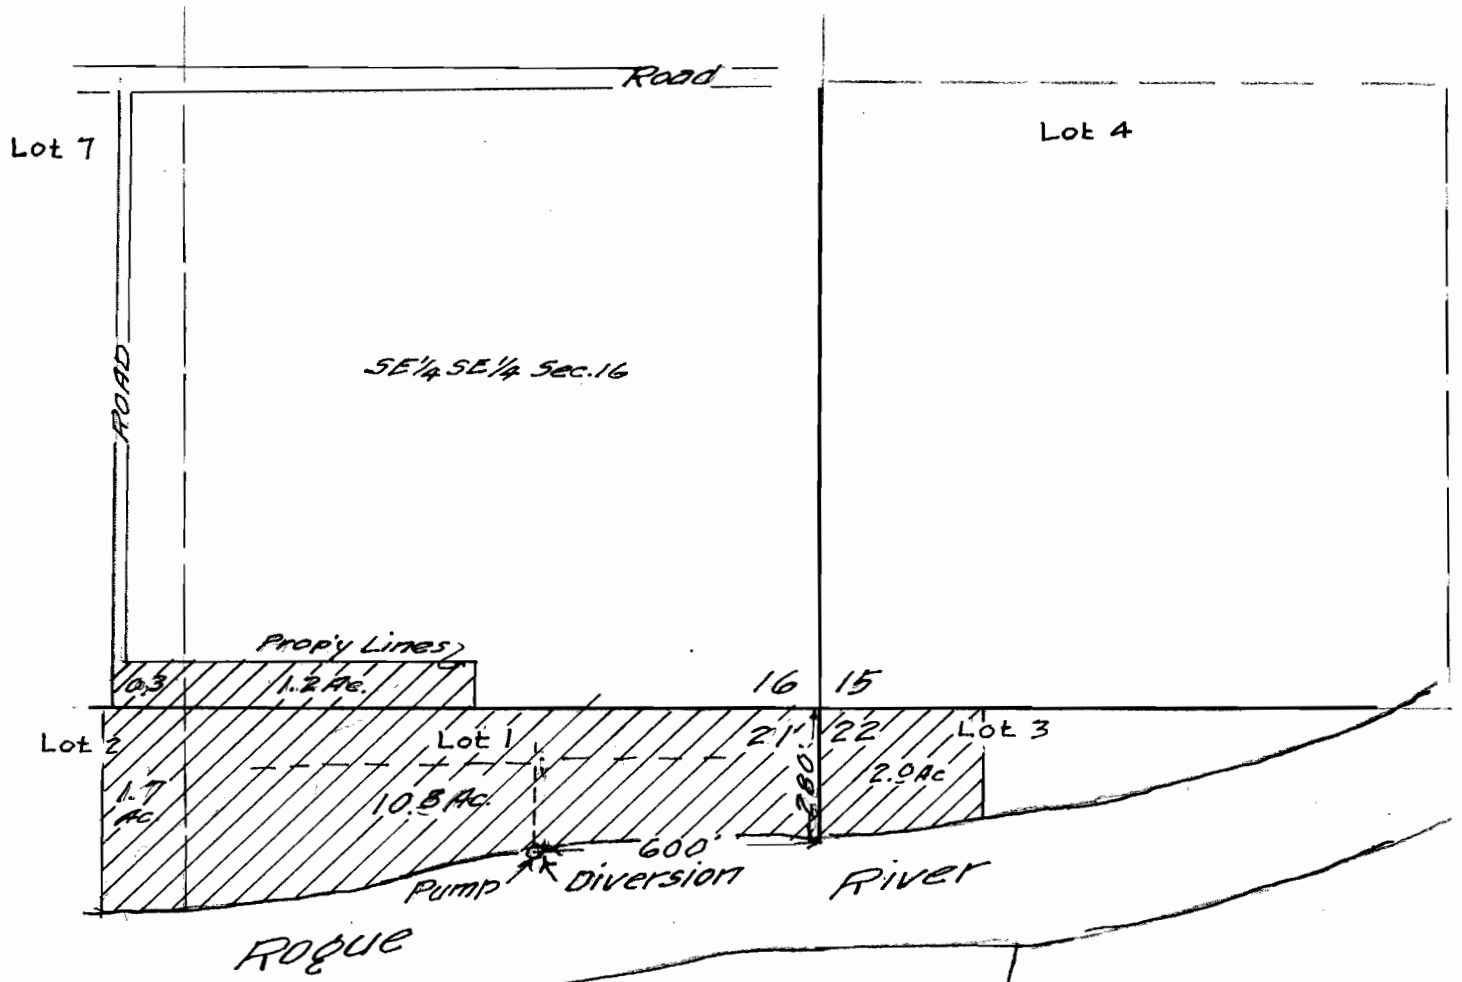

Application No. 27816
Permit No. 21882