


Map of Water System

of following described property:

W 1/2 of lot 25, Sec. 30, T6S, R10W, W.M.

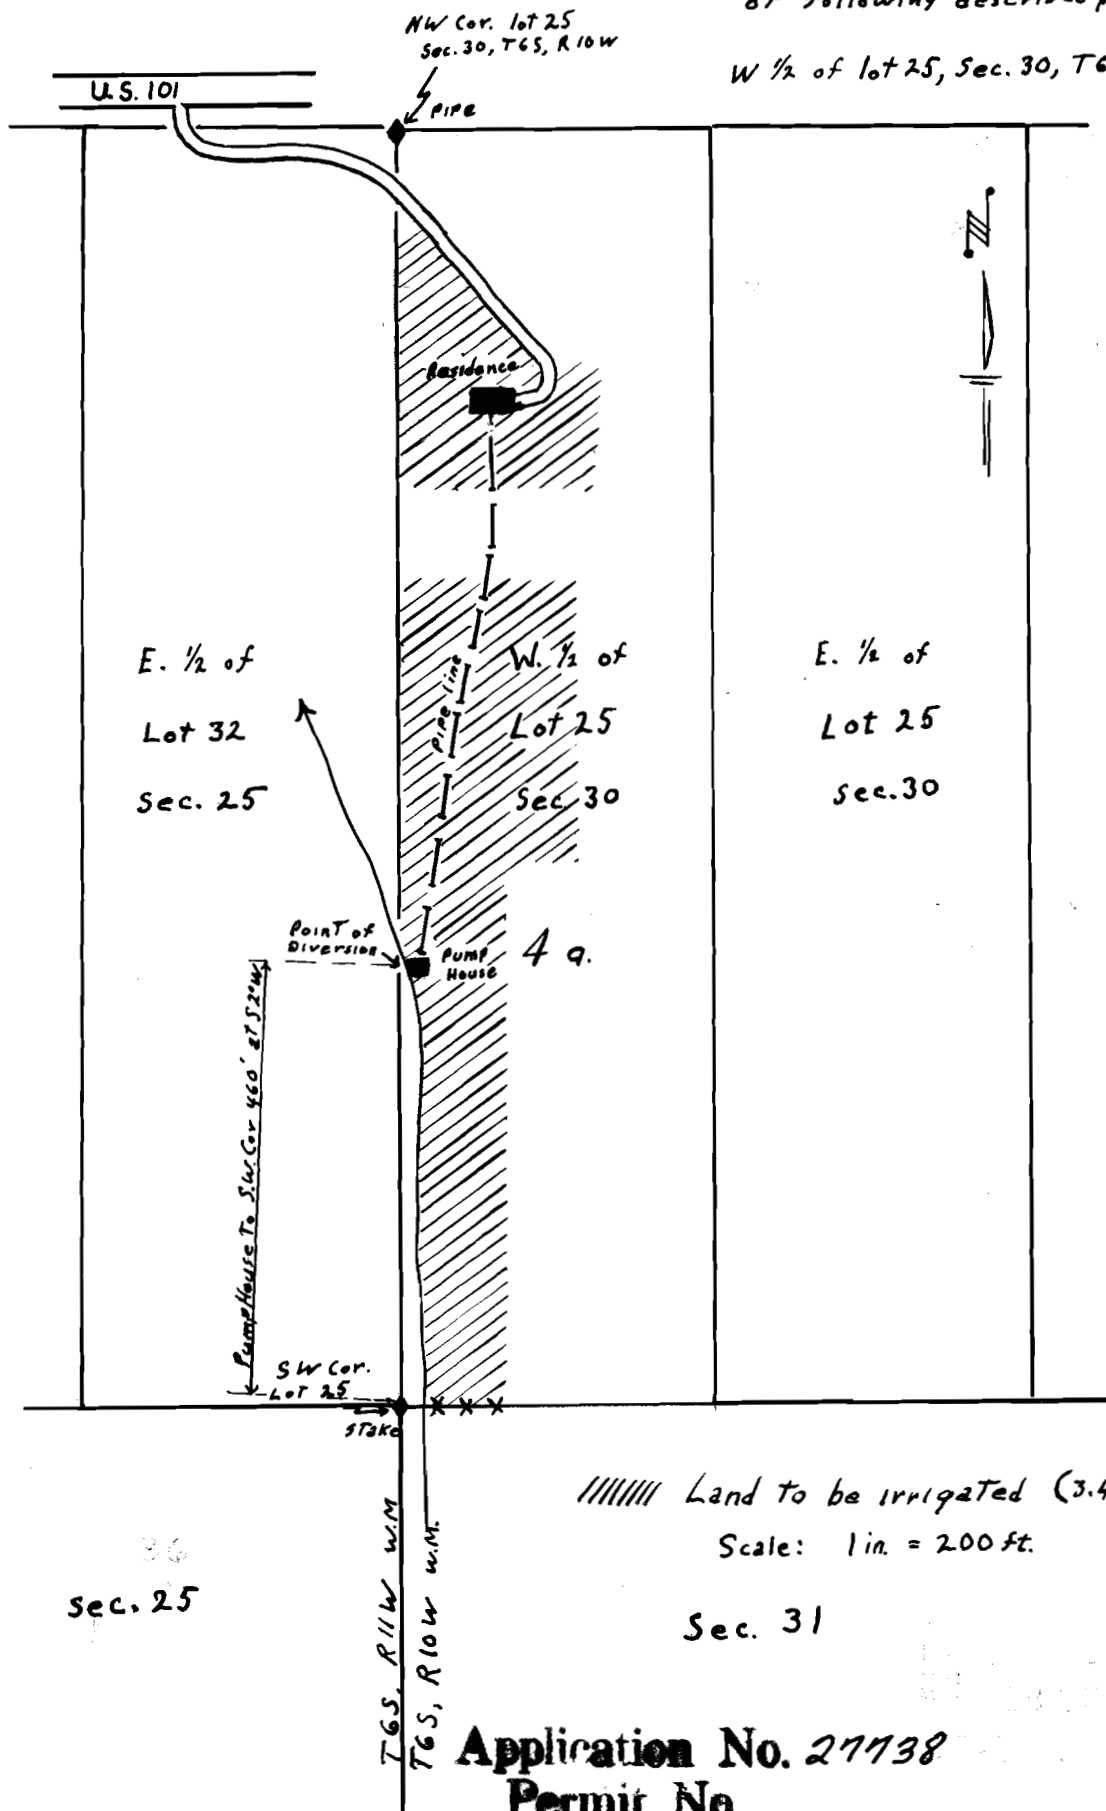

Application No. 27738
Permit No.