

SECTION


28

TOWNSHIP 16S, RANGE 2E, W. M.

North

LEROY ESTEVES

VIDA, ORE.

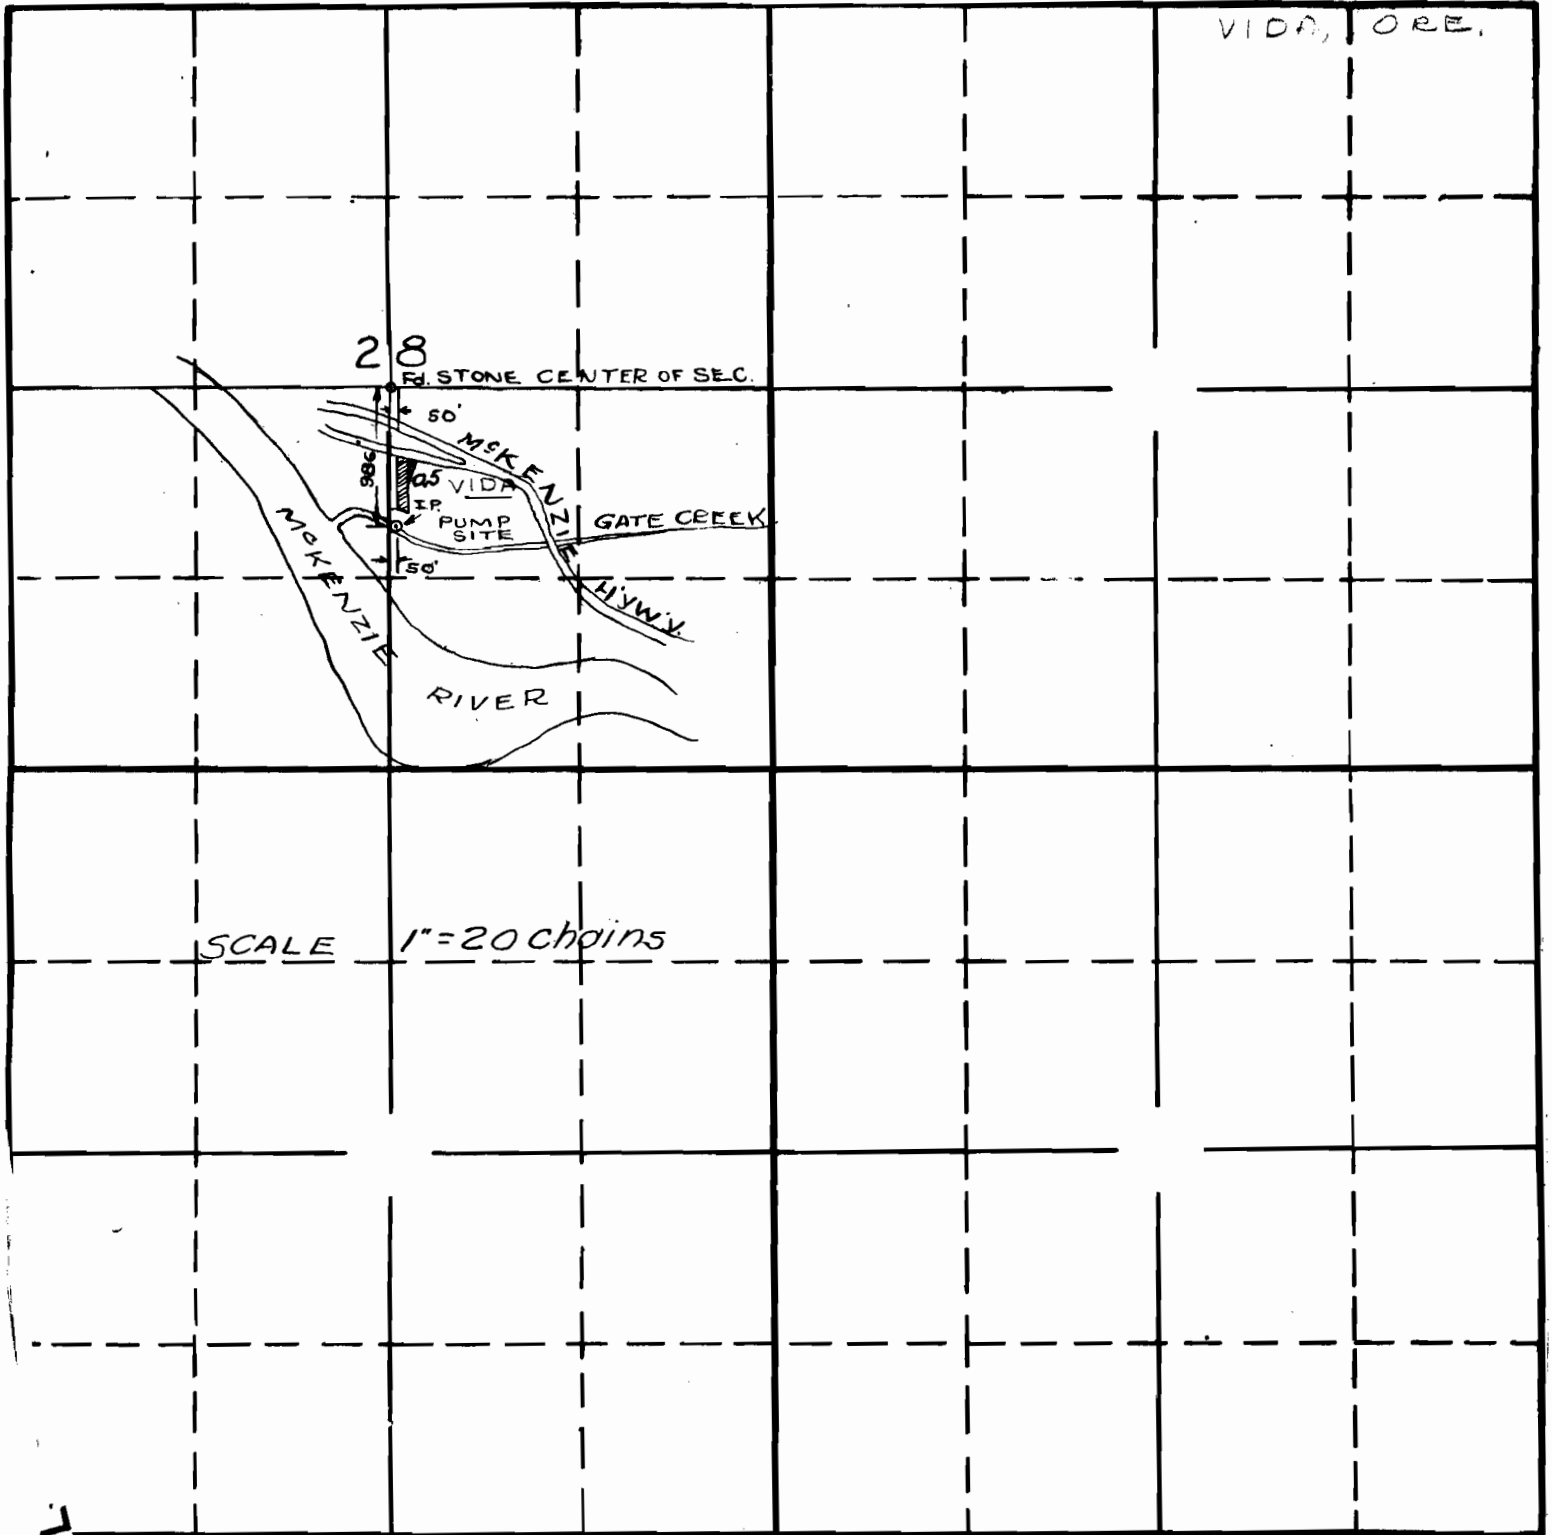

South

APPLICATION No. 28040

PERMIT No. 22060