


Permit: S 22071
Volume: 4A
Strm: S FK ROCKY G
Trib: ROCKY G
Priority: 2/02/53

T. 34 S. R. 8 W., W. M.
Scale 4" = 1 Mile Jan. 1953
Norman L. Lewis.

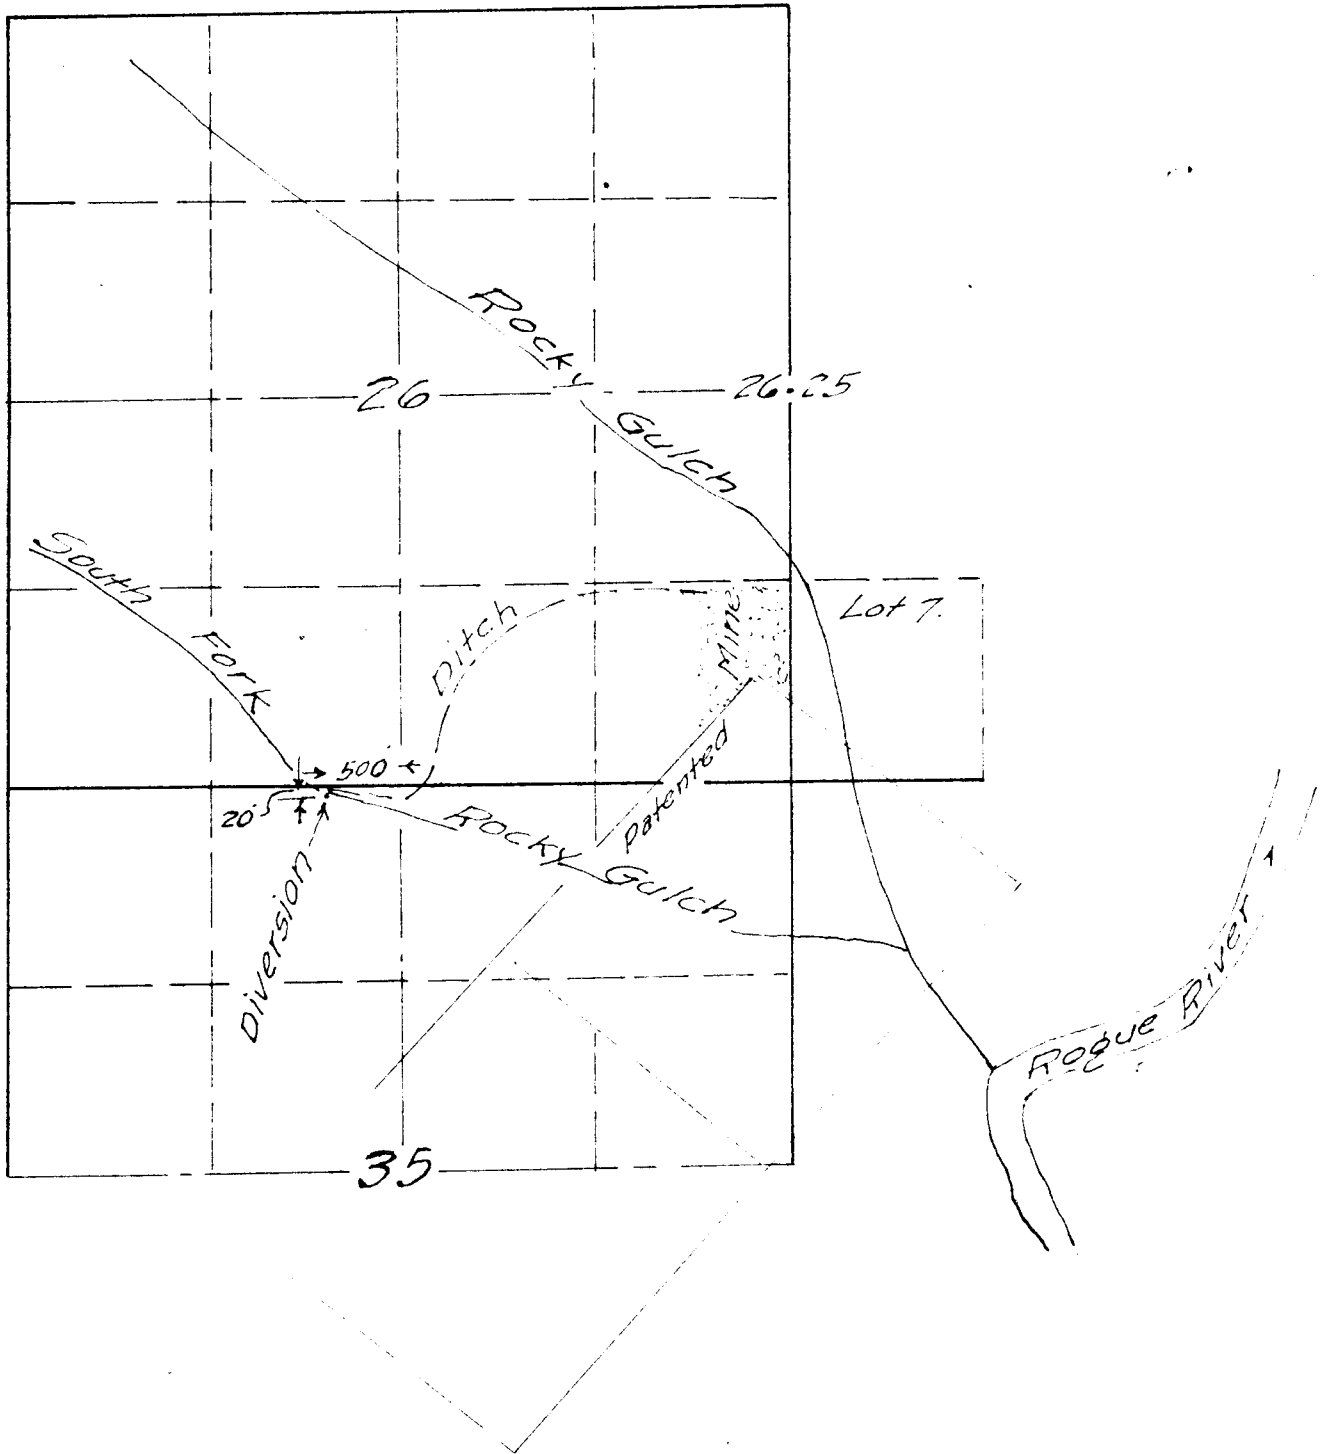

Application No. 28062
Permit No.