


Reference Monument is 1900 ft west and 800 ft north from the S.E. corner of sec 35 T1S R4W um.

N

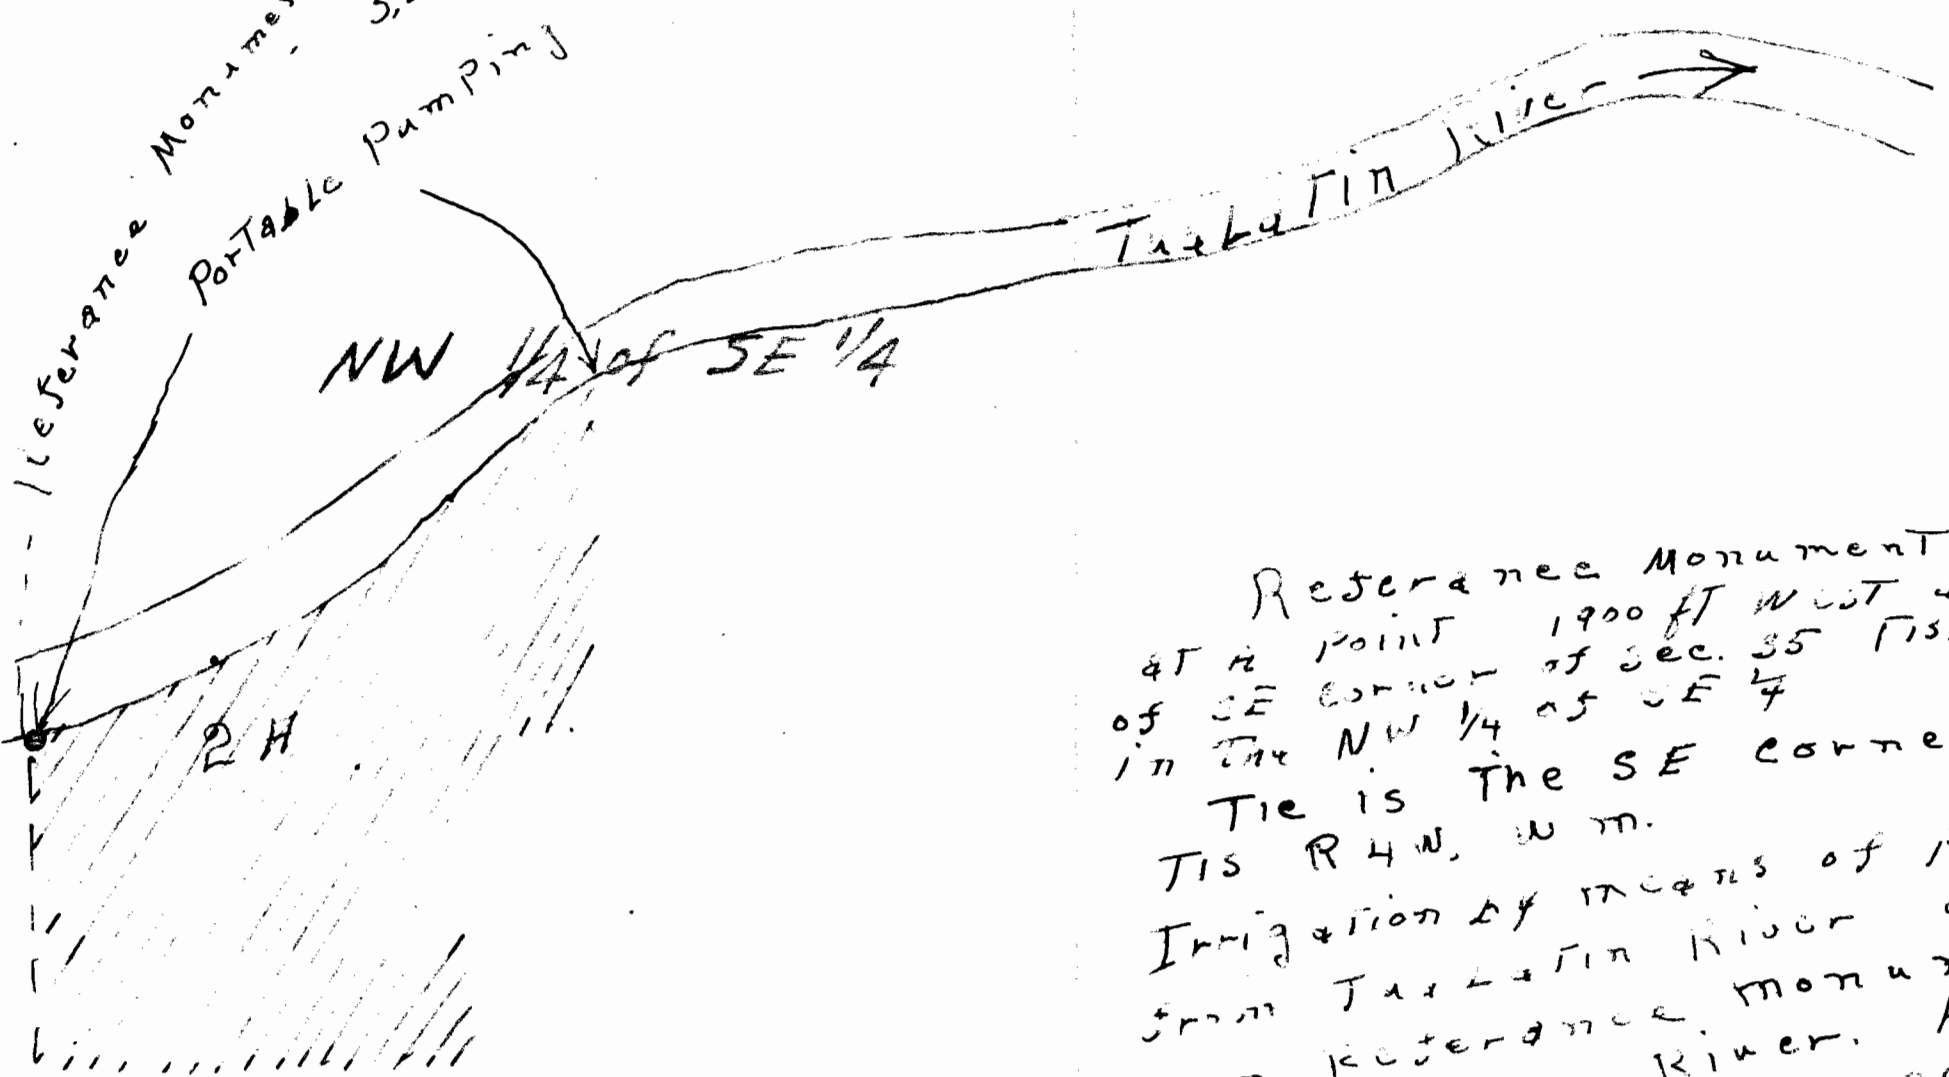

NW 1/4 of SE 1/4

NE 1/4 of SE 1/4

Reference Monument is located at a point 1900 ft west and 800 ft north of SE corner of sec. 35 T1S, R4W, um. in the NW 1/4 of SE 1/4. Tie is the SE corner of sec 35 T1S R4W, um. Irrigation by means of portable pump from Taxkutin River a long River from Reference Monument to a point 350 ft down River. All which is in the NW 1/4 of SE 1/4 of sec 35 T1S, R4W um.

Scale 100' to 1"

Center of SE 1/4 of sec 35, T1S, R4W.

SW 1/4 of SE 1/4

SE 1/4 of SE 1/4

Application No. 27963
 Serial No. 22112

Tie

T1S, R4W - 35
 T2S, R4W 21