


T. 36 S., R. 5 W., W. M.  
Scale 400' = 1" Feb. 1953  
Kenneth S. Martin

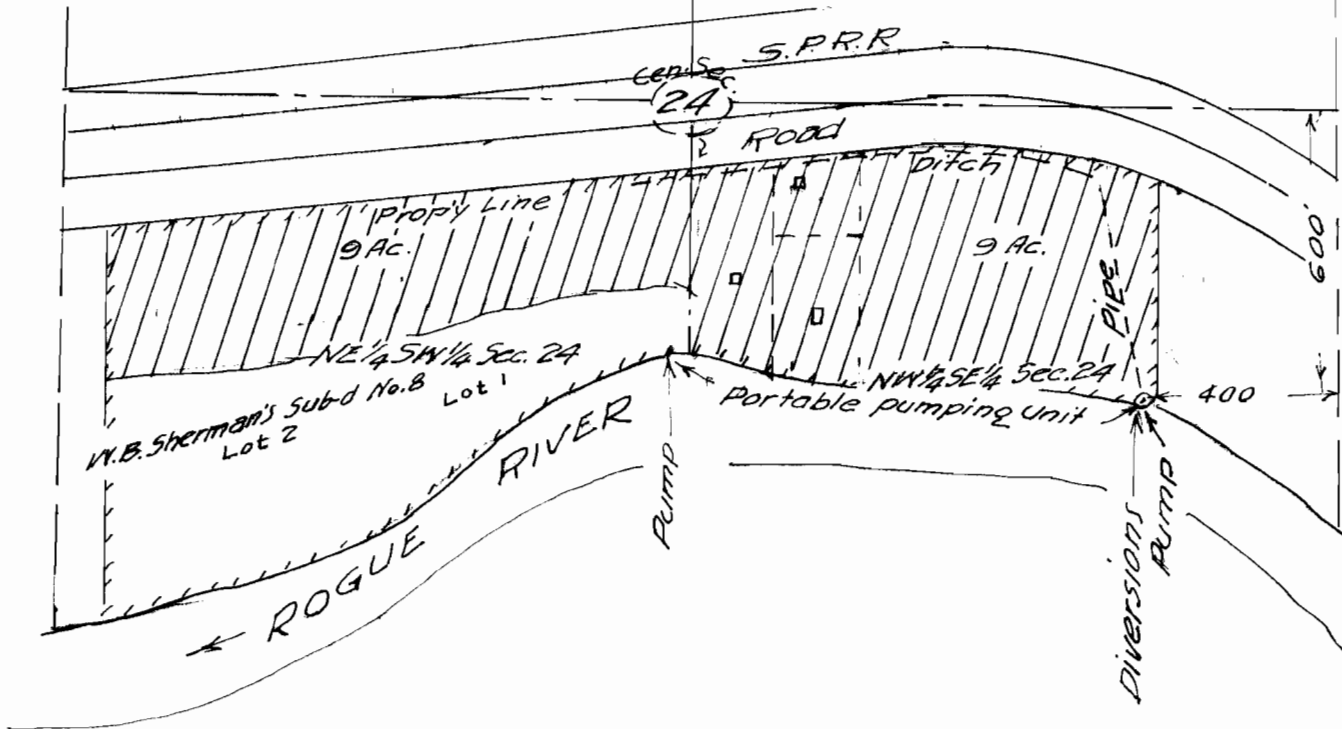

Application No. 28108  
Permit No. 22127

28108