

N


Tp 2 N. R. 4 W. Wm




N 39° 40' W / 1920' from SE Corner Sec 14

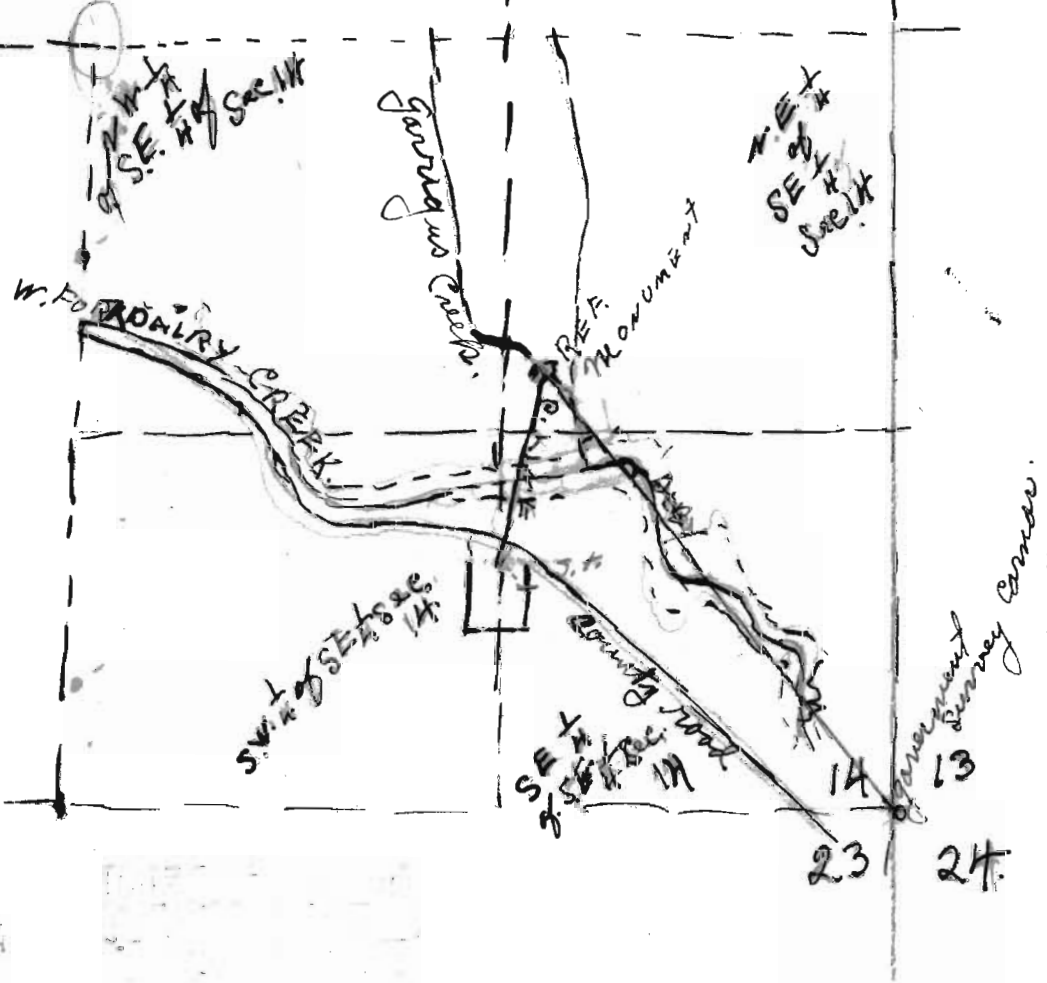

Application No. 28150
Permit No. 22155