


T.37 S., R.5 W., W.M.
Scale 4"=1 Mile Mar. 1953
Stanley Grow.

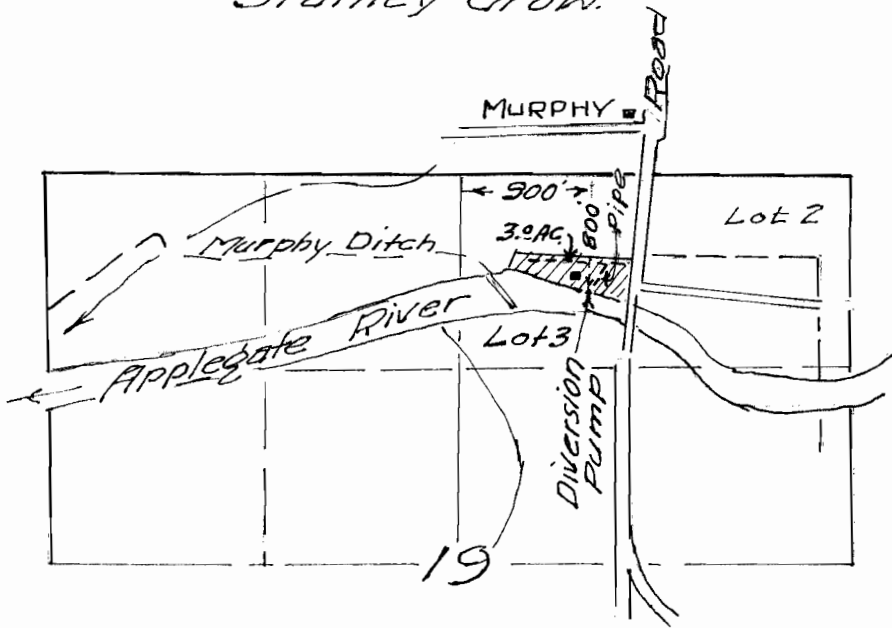

Application No. 28264
Permit No. 28224