


MAP ACCOMPANYING FINAL PROOF OF
M. C. ROWDEN, FOR USE OF WATER FROM AN
UNNAMED STREAM FOR IRRIGATION PURPOSES.

APPLICATION No. 28272
PERMIT No. 22228

COPIED FROM PLANE TABLE SURVEY, MADE 1-14-53
David L. Hendrix, W.M.

SECTION 15, T. 38 S., R. 4 W., W. M.

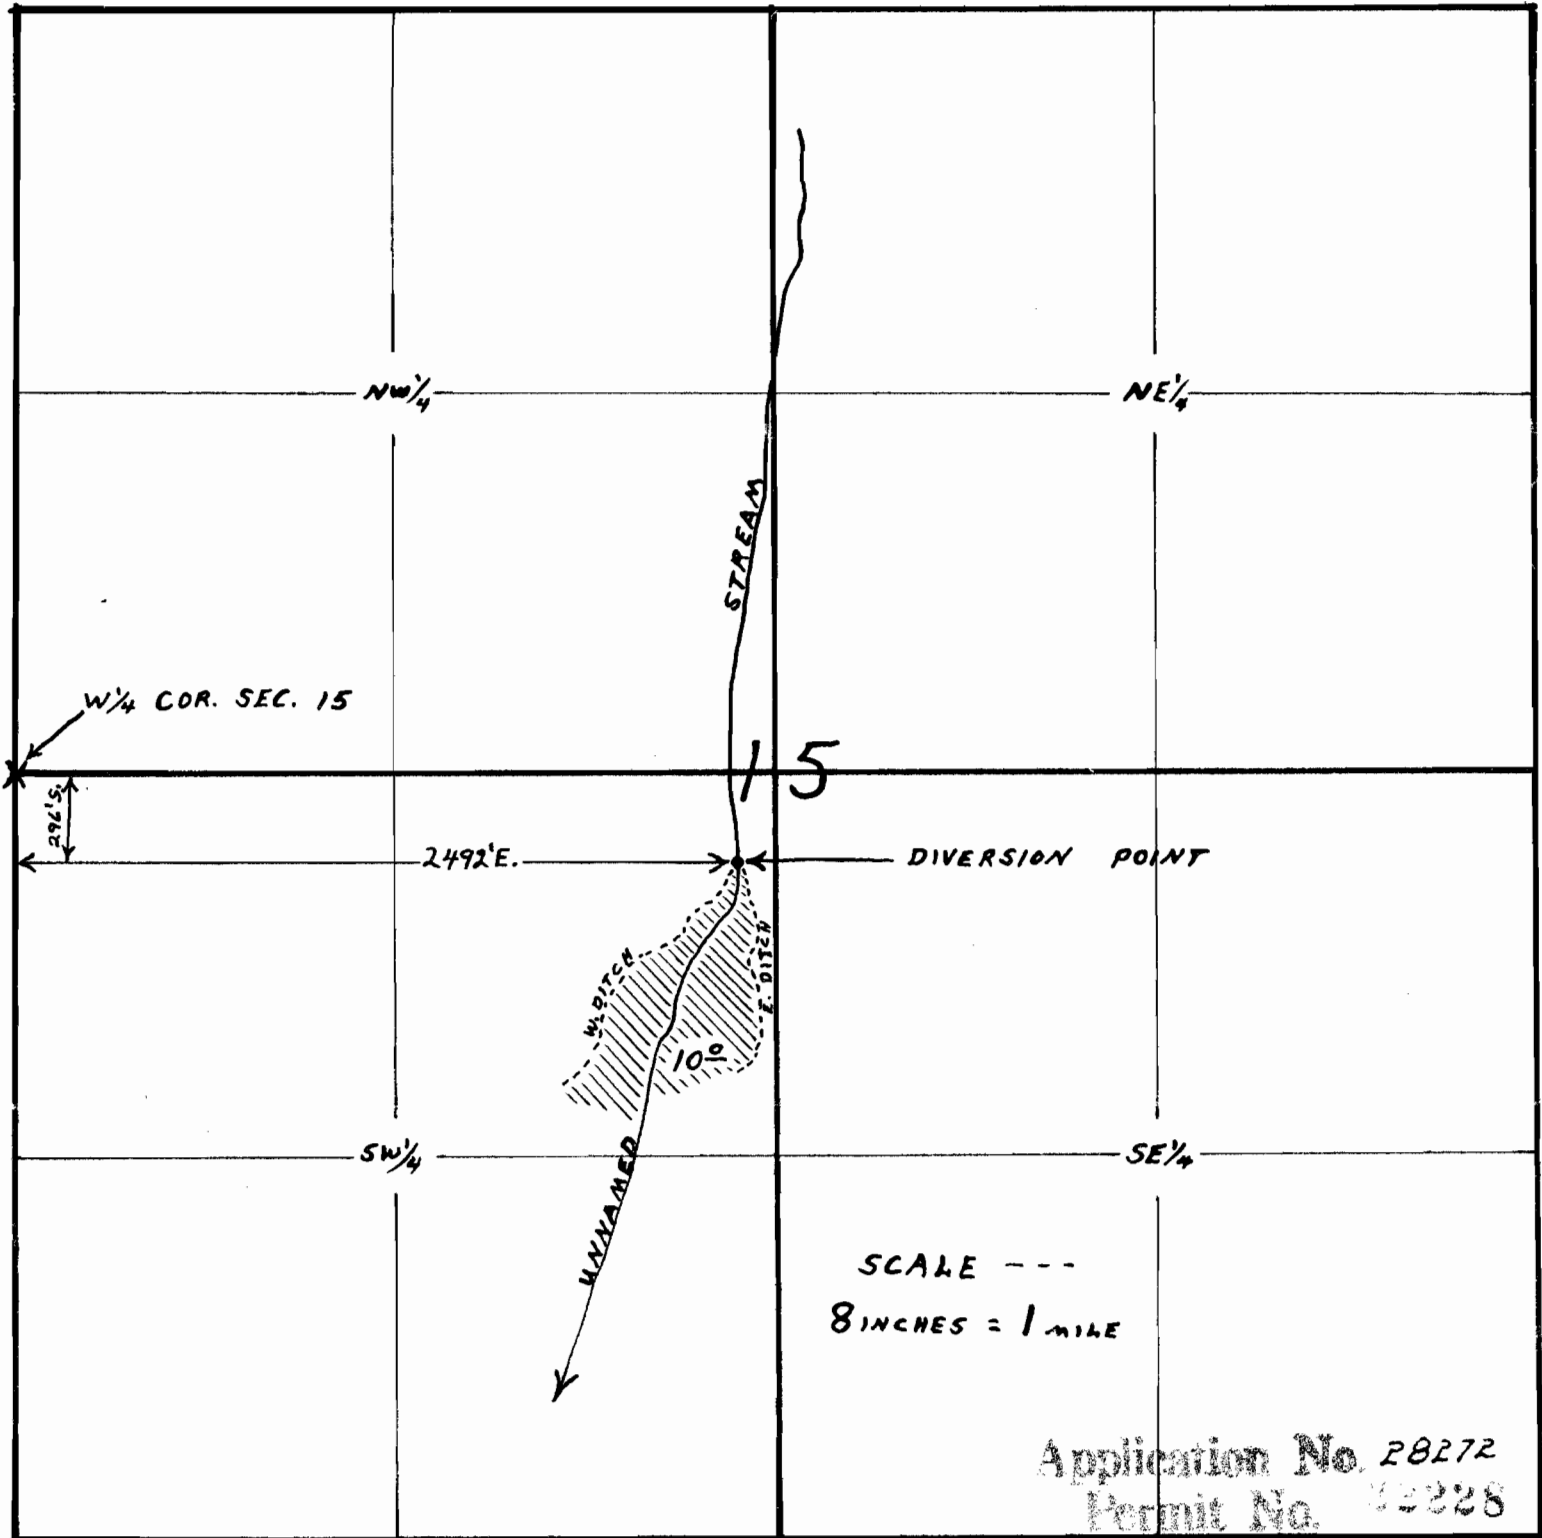

MAP TO ACCOMPANY APPLICATION OF
M. C. ROWDEN, FOR USE OF WATER FROM
UNNAMED STREAM FOR IRRIGATION
PURPOSES.

THIS OFFICE 3-30-53

David L. Hendrix

Application No. 28272
Permit No. 22228

RECEIVED
MARCH 30 1953

STATE ENGINEER
DEPARTMENT OF AGRICULTURE