


919.7' north

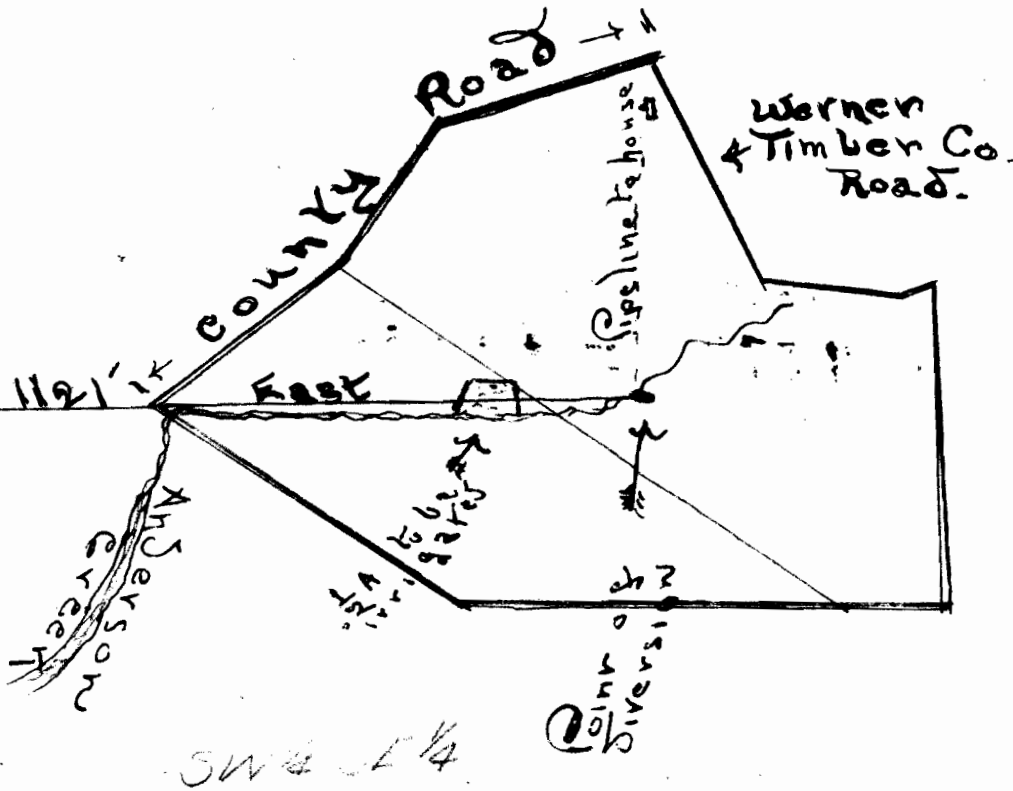

T. 7. S. R. 11 West
 Lincoln County

• $\frac{1}{4}$ Cor. between
 Sec's. 25 + 36

Application No. 28402
 Permit No. 22268