

W. R. 201


H. WHITTLE IRRIGATION WORKS

SEC. 21, T. 11 S., R. 1 E., WILL. MER.


LINN COUNTY, ORE.

Scale: 1" = 400'


May 12, 1953

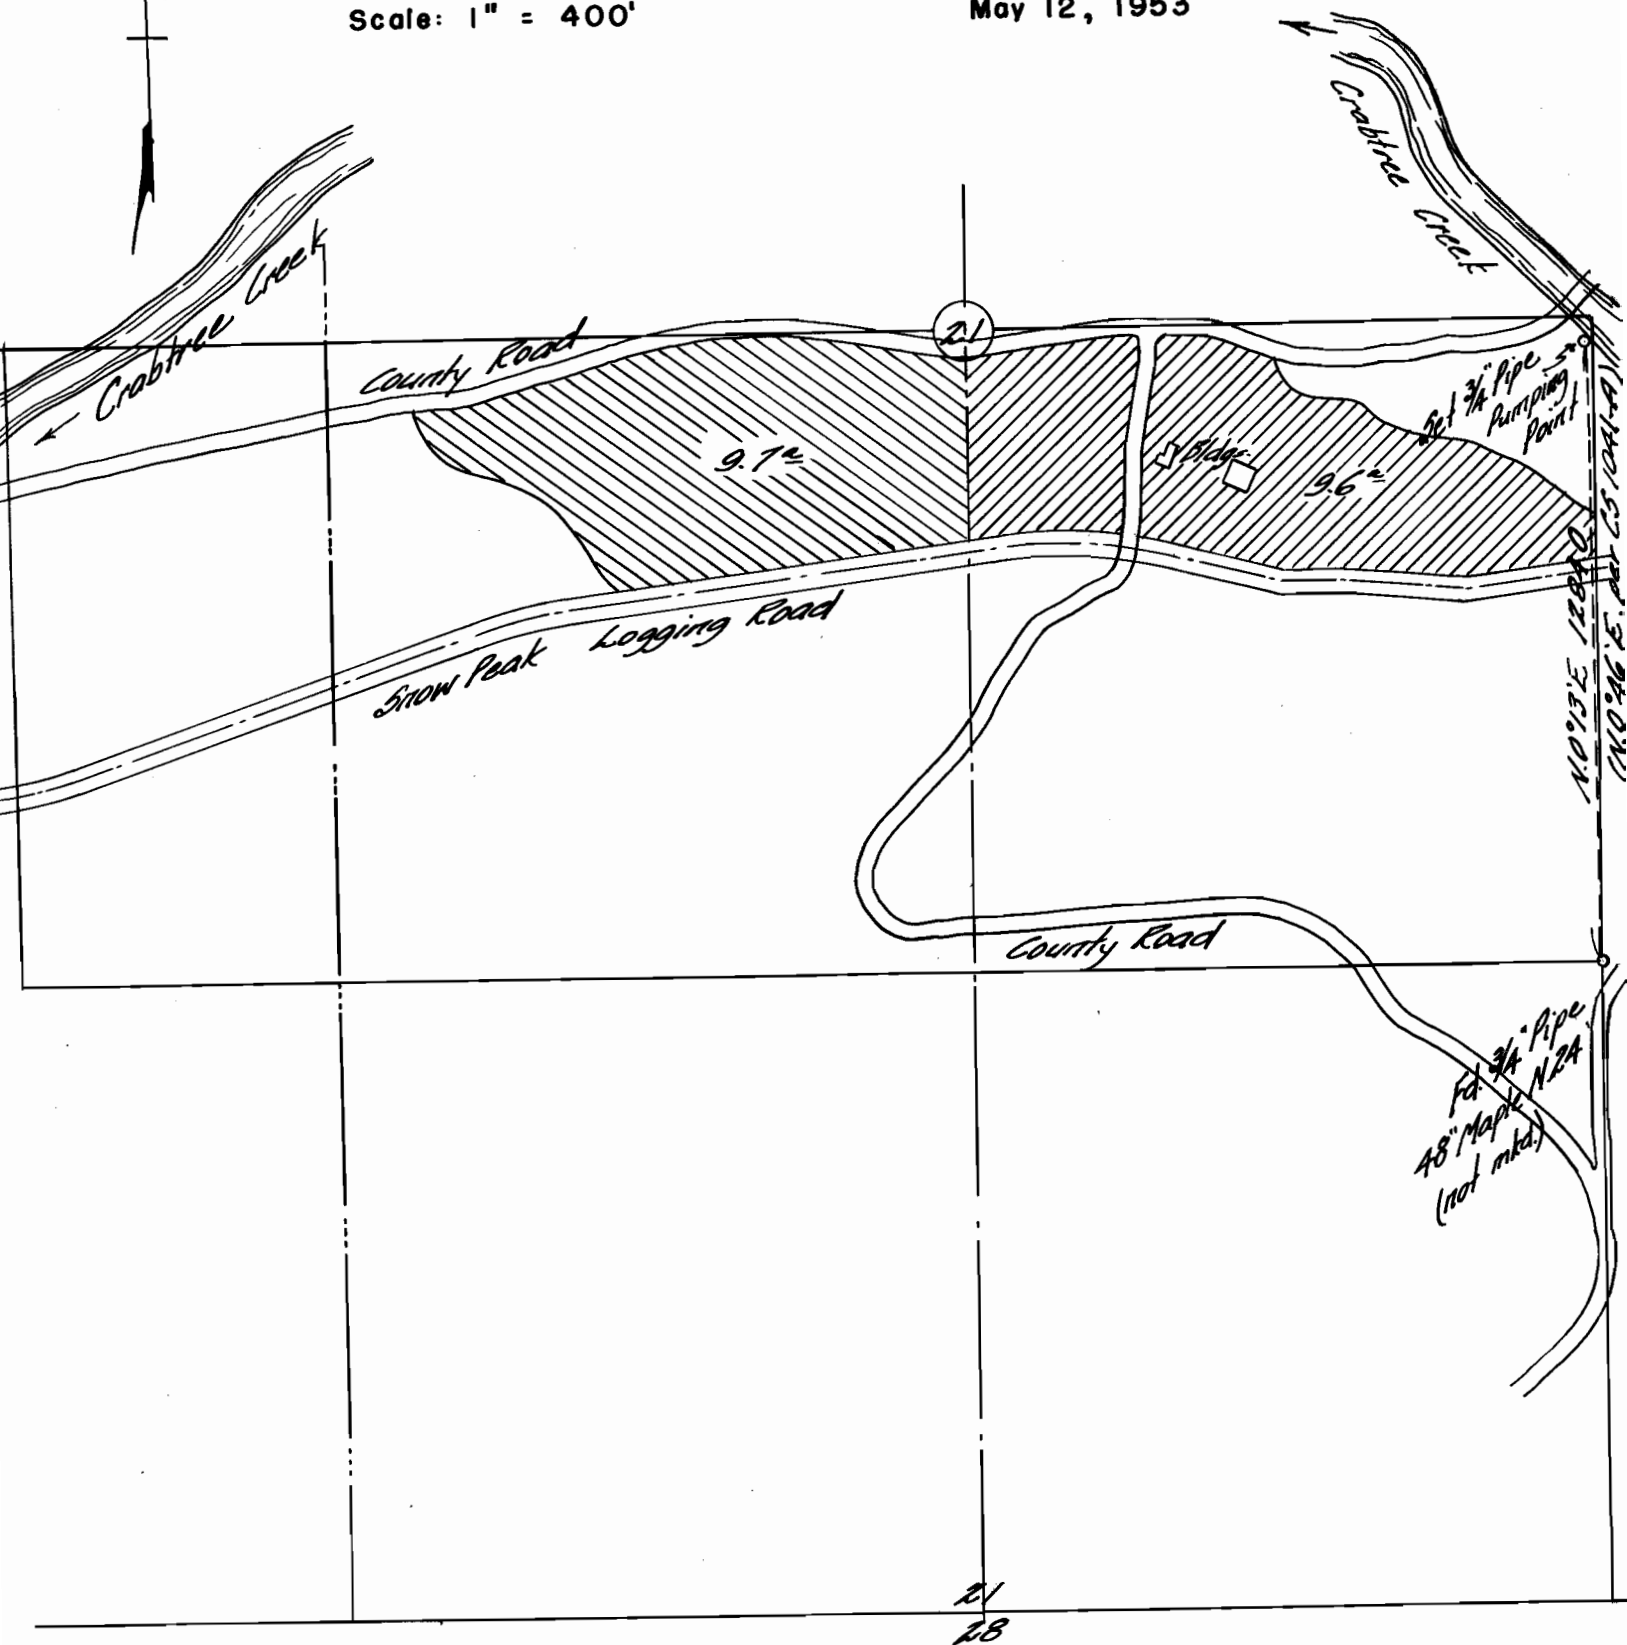

I, Orris A. Carnegie of Albany, Oregon, do hereby certify that this map was made from notes taken during an actual survey made by me on May 12, 1953 and supplemented by information taken from the latest aerial photographs; that the monument the monument shown on this map consisting of a 3/4" iron pipe is N. 0° 13' E. 1284.0 feet from the Southeast corner of the Northwest 1/4 of the Southeast 1/4 of Section 21 in T. 11 S., R. 1 E. of the Will. Mer. in Linn County, Oregon.

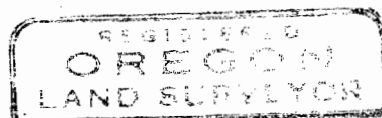

Orris A. Carnegie

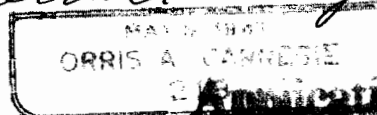

Application No. 2845

Permit No. 22280