


T. 34 S., R. 6 W., W. M.

Scale 8" = 1 Mile

May 1953

G. T. Kennedy

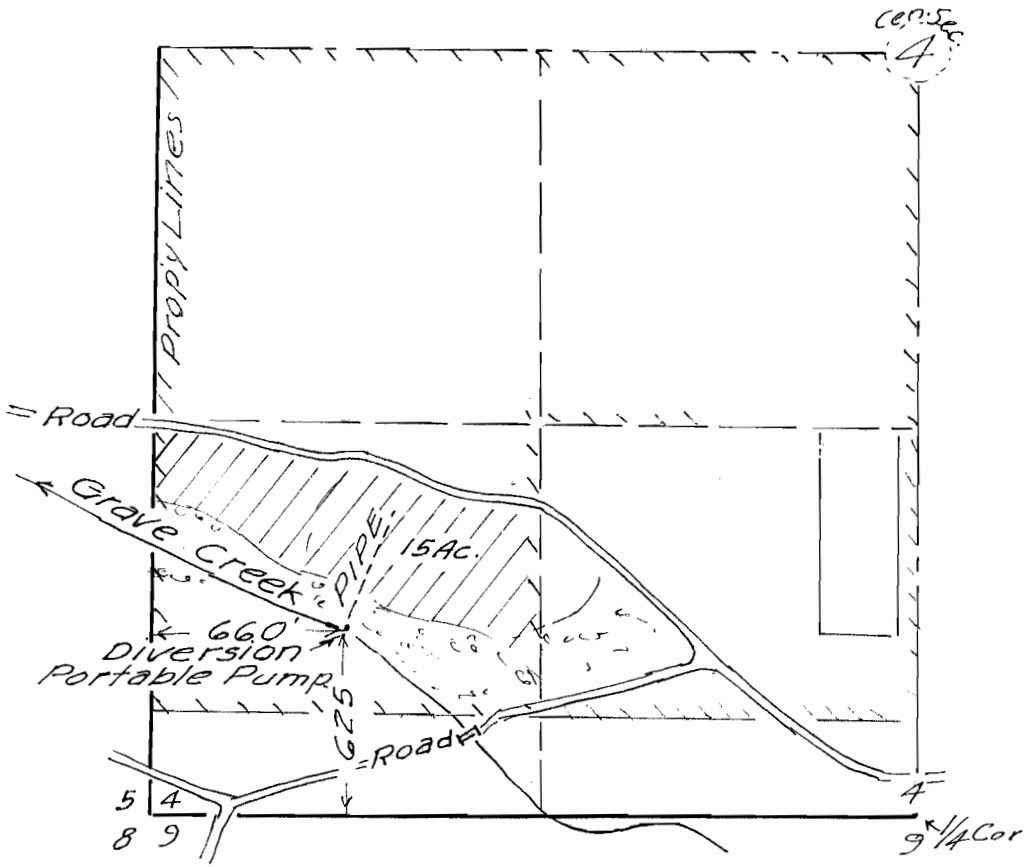

Application No. 28468  
Permit No. 12295