


39-5-24  
Perm. 22402

T.39S. R.5W.W.M.

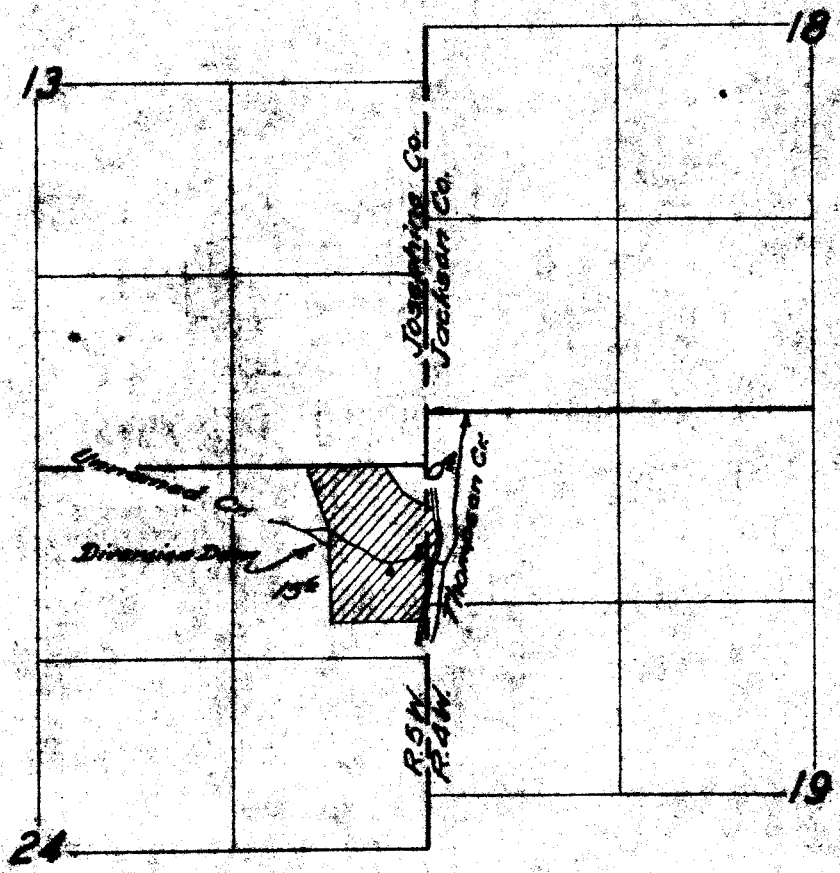

FINAL PROOF SURVEY

UNDER

Application No. 22396 Permit No. 22402

IN NAME OF

FRANK DECKER

Surveyed July 24 19 59, by Carroll