Notes_ Wm. Spence filed Notice of Appropriation of 3/3 of waters of Rock Creek, Sept. 1888. Page 35. Vol. 1, Book of Water Rights, Records of Klamath County_ Intends to use in "Balls Bay", Lots 7, 8 & 9, Sec. 32; Lots 4-5-6-7-8-1, Sec 33; Lots 3 & 4, Sec. 28, T. 36 S., R 7 E. W.M.

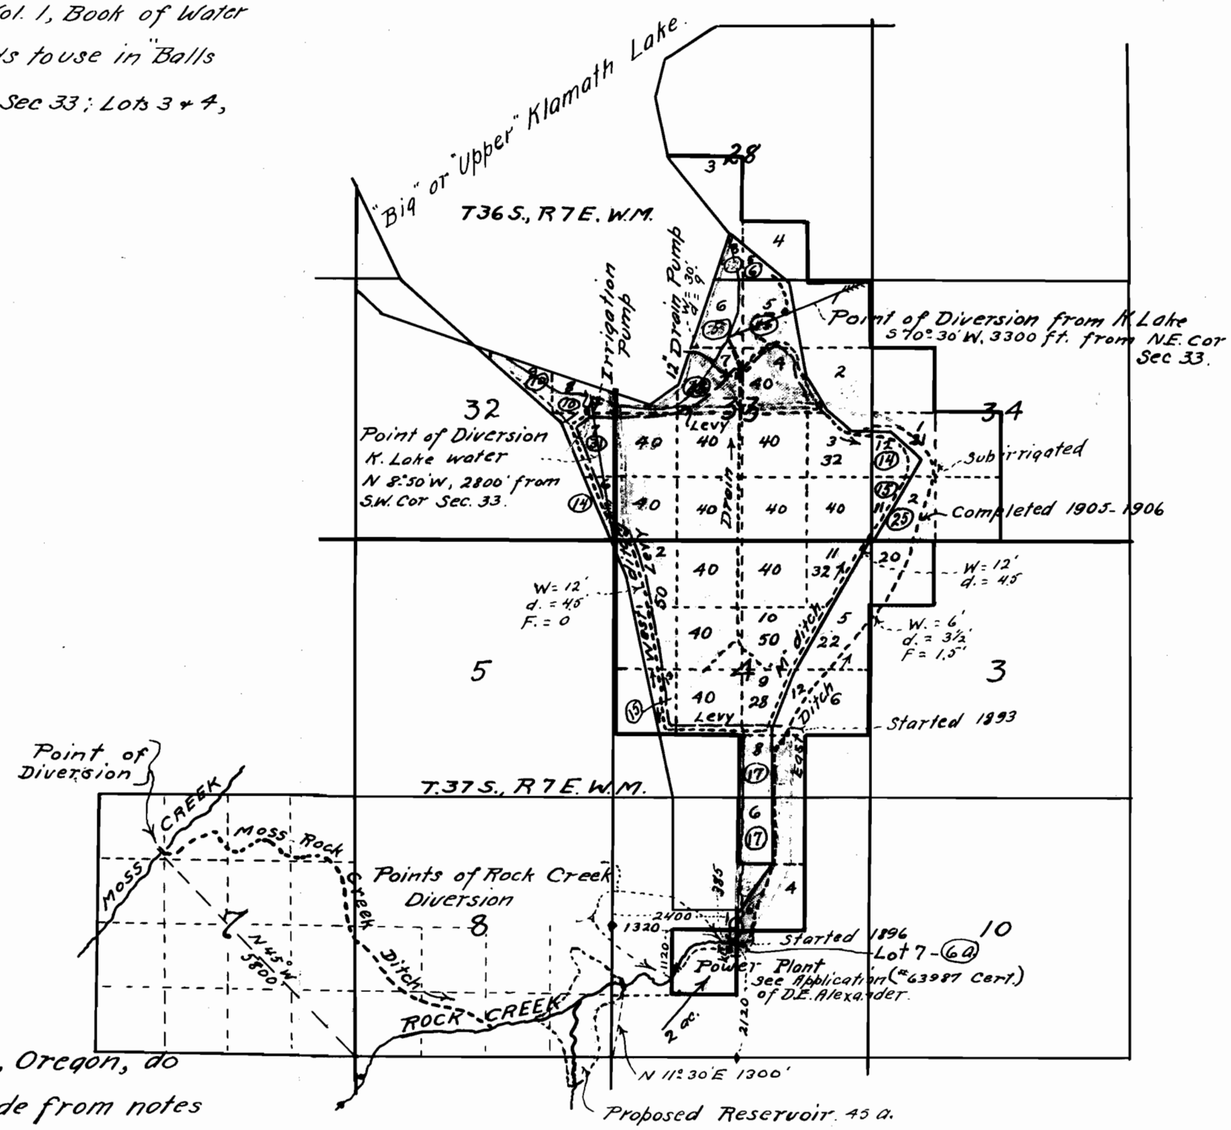

I, John C. Cleghorn, of Klamath Falls, Oregon, do hereby certify that this map was made from notes taken during an actual survey made by me on June 30, 1923, and March 19, 1929; July 22, 1929, and Sept. 11 to 17, 1929 and Sept. 27, 1930; and that it correctly represents the works described in the accompanying Application, together with the location of streams and other ditches in the immediate vicinity._

John C. Cleghorn
Reg. Prof. Engr #115.

RECEIVED
NOV 5 1931
SALEM, OREGON

Map accompanying Application and Proof of Claim to waters of Rock Creek and Upper Klamath Lake and Moss Creek by D. E. ALEXANDER

Date_ Sept, 1931 Scale 2 in. = 1 mi.

9-30-'31
John C. Cleghorn

Application No. 14426
Permit No. 22472