


35-7-15

T. 35 S. R. 7 W. W.M.

Scale 4" = 1 Mile. July 1953.

Harold E. Fowbridge

ROGUE RIVER

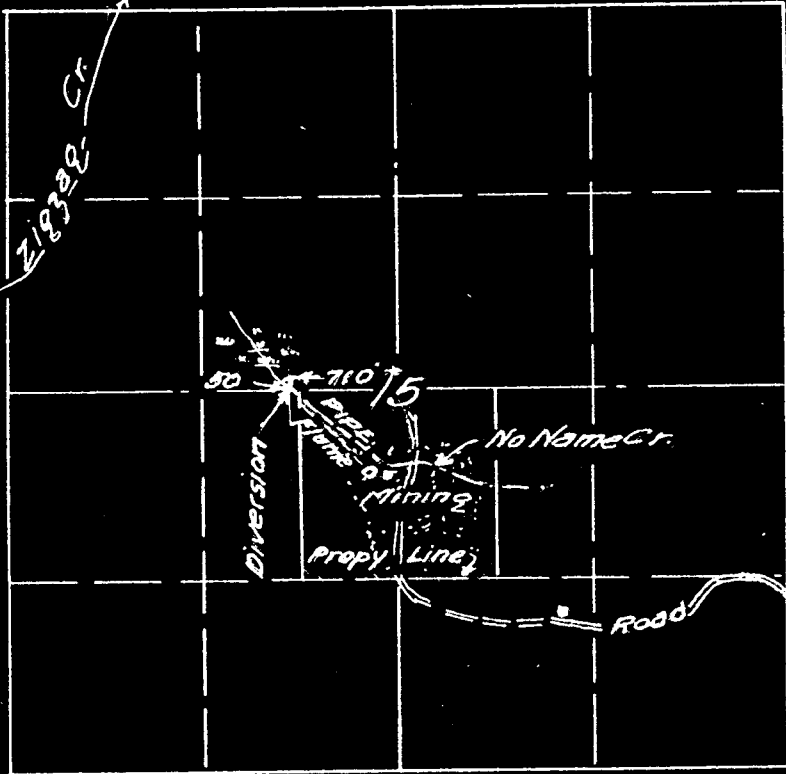

Applicant No. 28669
Fund No. 22576