


T. 36 S., R. 6 W., W.M.  
Scale 400' = 1" Sept. 1953  
J. P. McCourtney

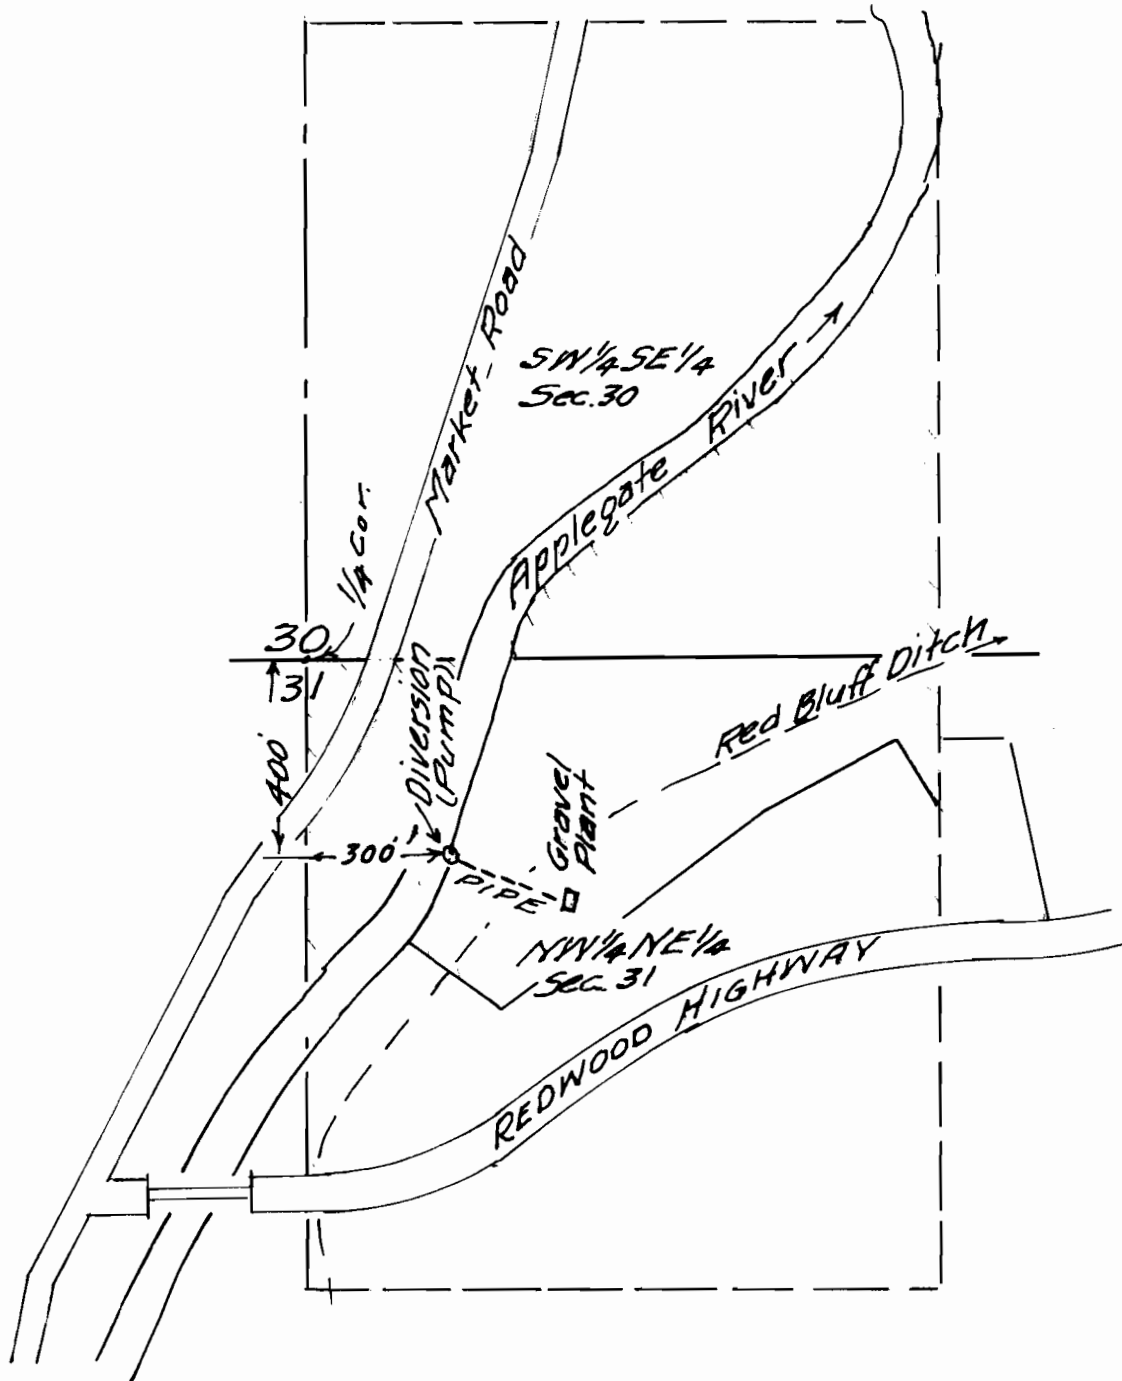

Application No. 28790  
Permit No. 22661