


36-7-21

Permit 22662

T.36S.R.7W.W.M.

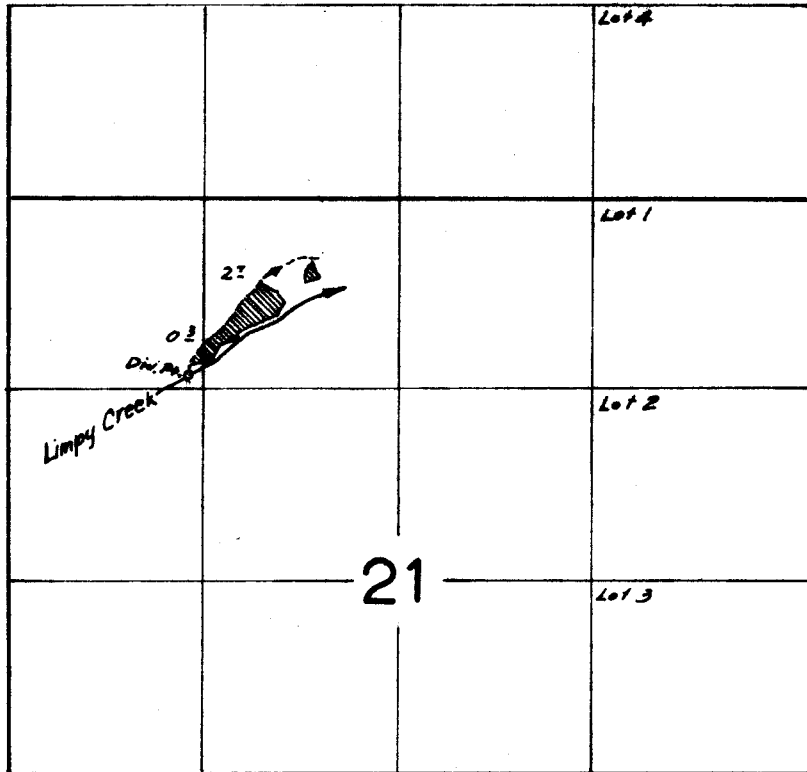

FINAL PROOF SURVEY UNDER

Application No. 28791 Permit No. 22662
IN NAME OF

J. Z. & PHILA E. WALKER

Surveyed July 24, 1959, by *R. Jackson*

1959-G