T. 19 S. R. 47 E.W.M.

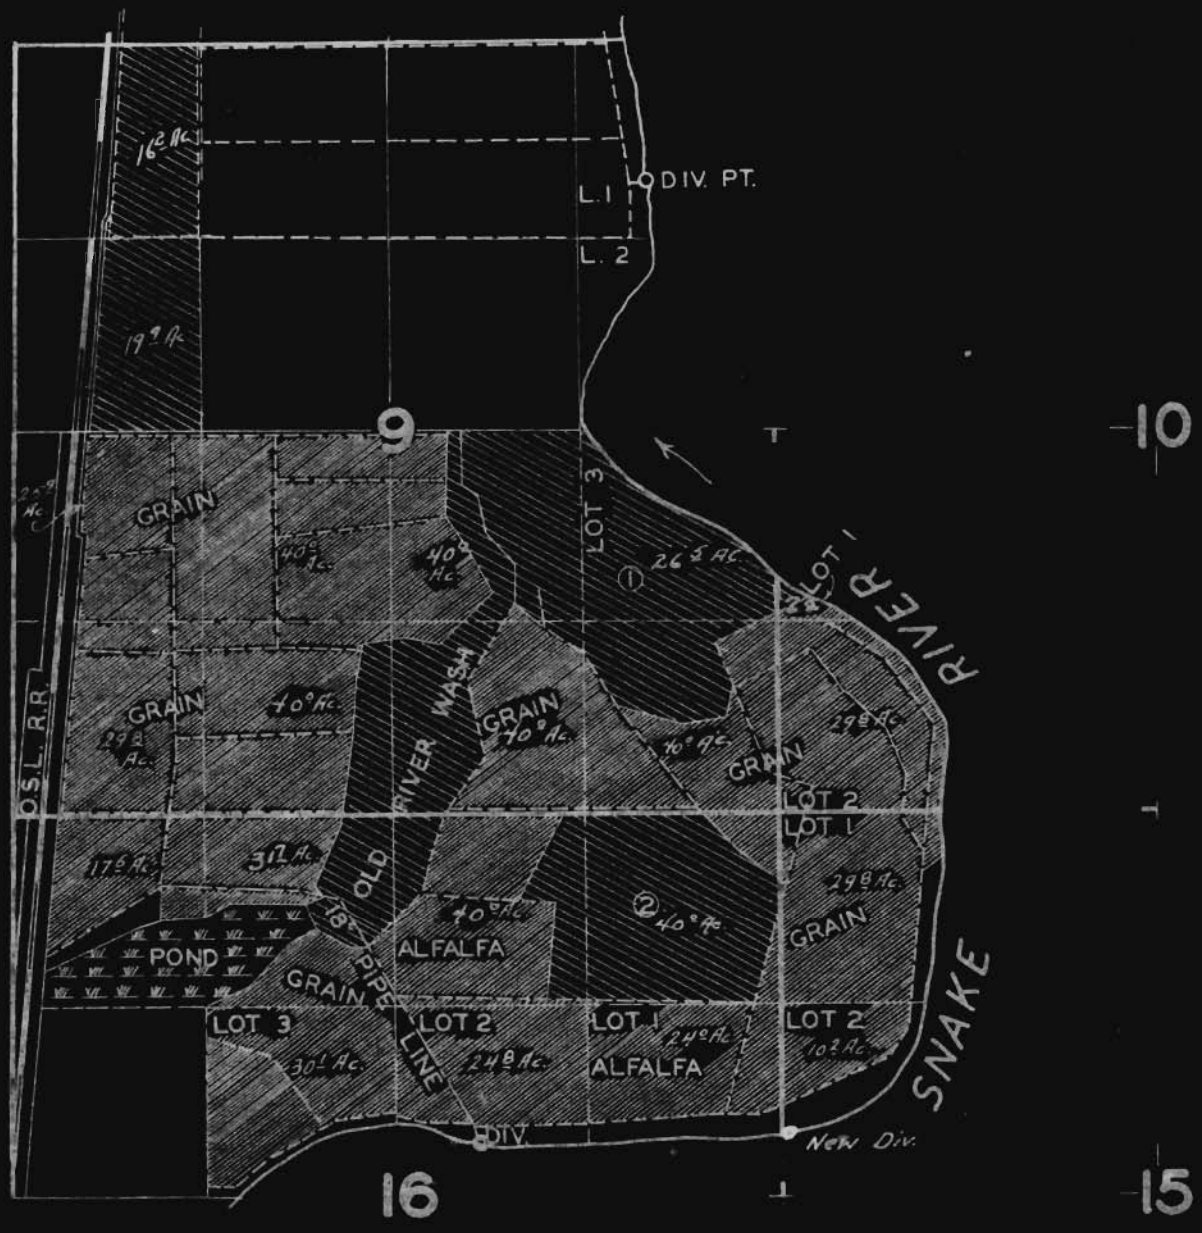

FINAL PROOF SURVEY

UNDER

Application No. 17199 Permit No. 12923

IN NAME OF

WILHEMINE KIESEL SHEARMAN & WILHEMINE KIESEL SHEARMAN-TRUSTEE

Surveyed JUNE 1 1946, by

Application No. 28848

Permit No. 22694

1946 – C