


T. 13S. R. 20E. W.M.

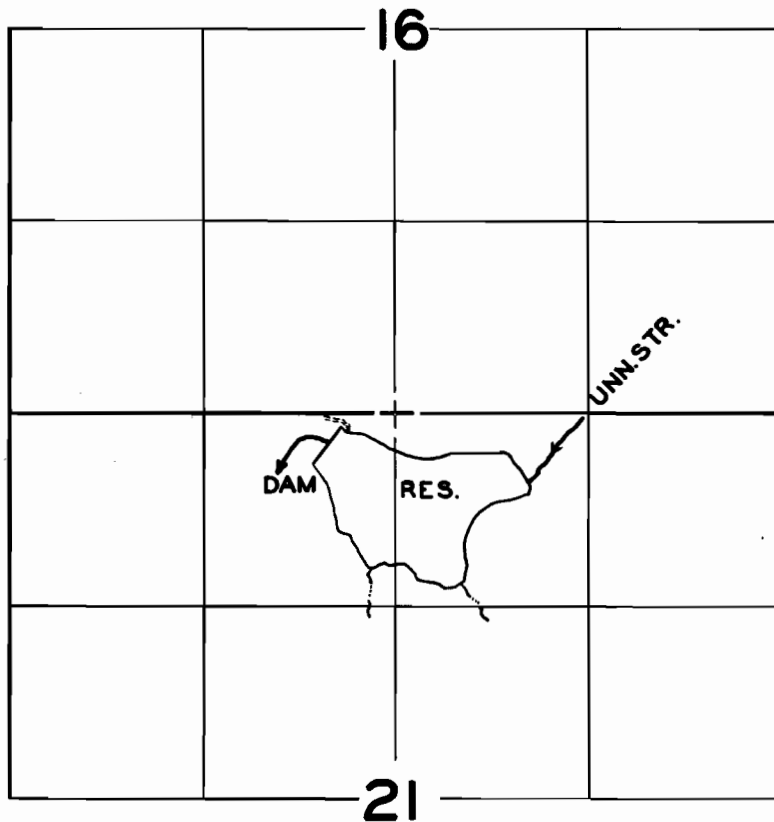

FINAL PROOF SURVEY

UNDER

R-28812


R-1575

Application No. 28895. Permit No. 22717.

IN NAME OF

PRINEVILLE CHAPTER, IZAAC WALTON LEAGUE OF AMERICA

Surveyed AUG. 9 1957, by C.O. BARTELS

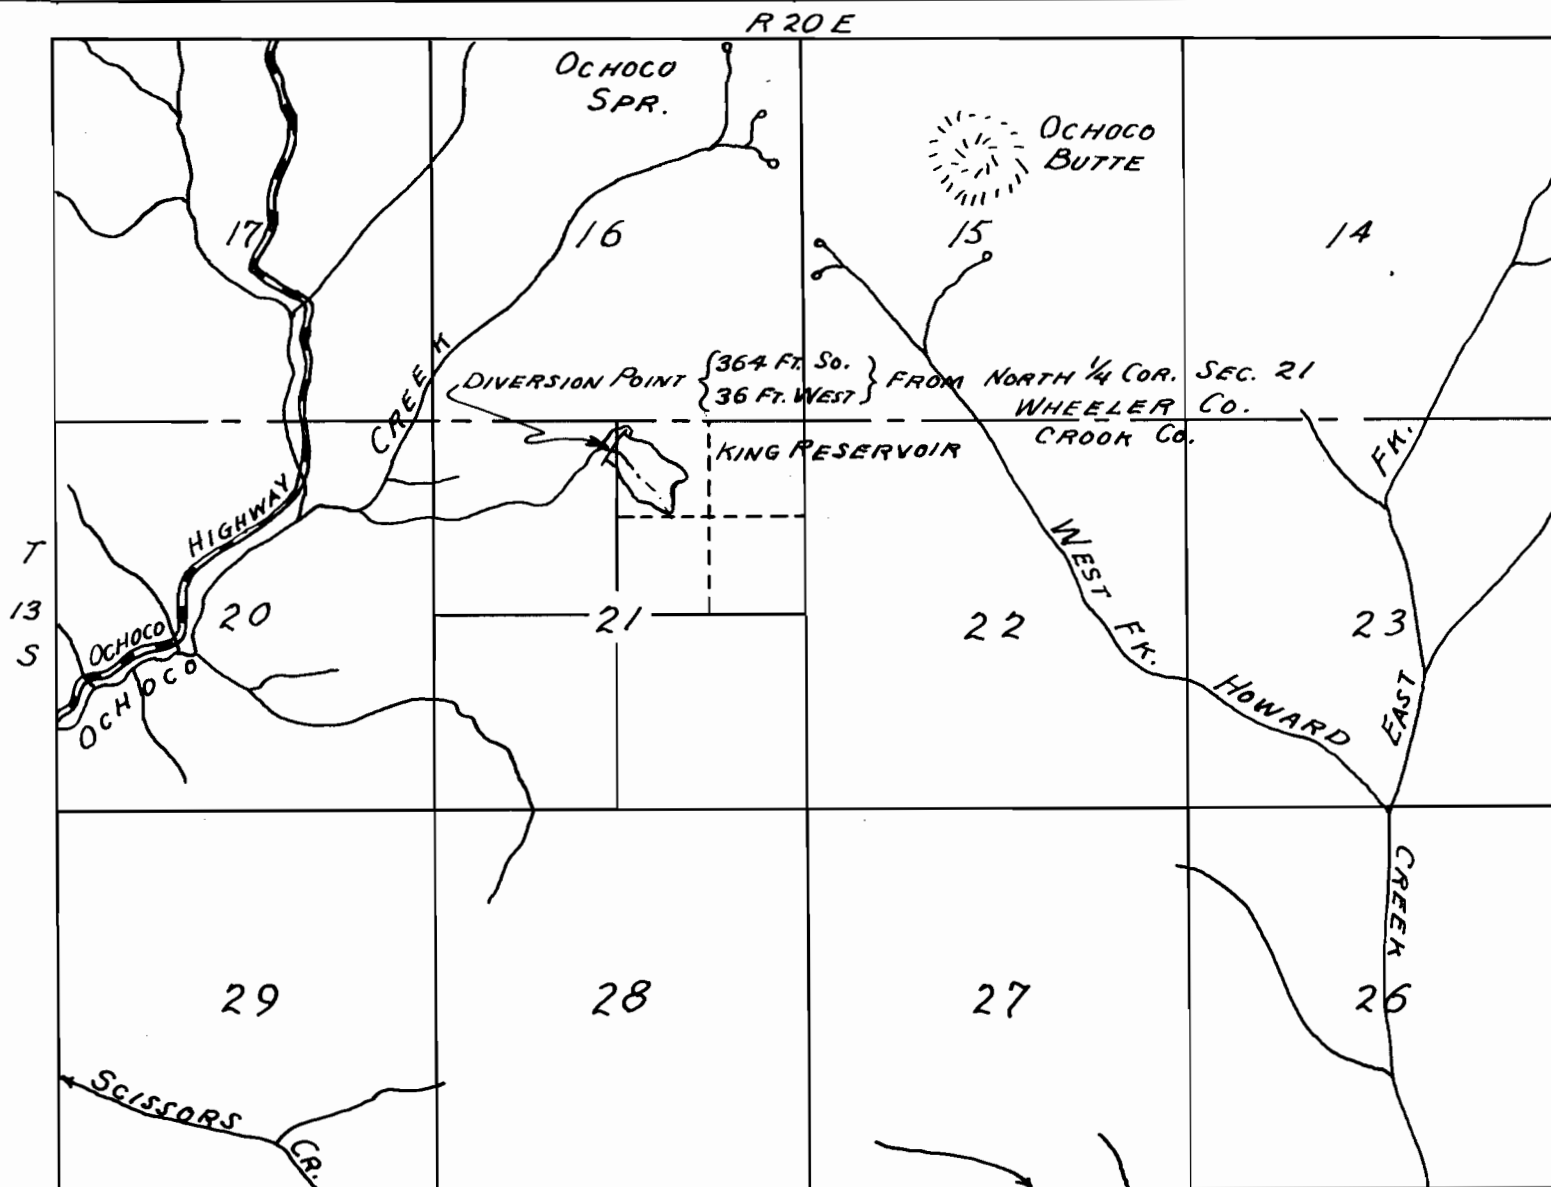

MAP TO ACCOMPANY APPLICATION FOR PERMIT
 TO APPROPRIATE WATER **Application No.**
1575 Permit No.

R-28812
 28895

PRINEVILLE CHAPT., ISAAC WALTON LEAGUE OF AMERICA: APPLICANT

I, FRED D. GUSTAFSON, OF PRINEVILLE, ORE. DO HEREBY CERTIFY THAT THIS MAP WAS MADE FROM NOTES TAKEN DURING AN ACTUAL SURVEY MADE UNDER MY IMMEDIATE SUPERVISION ON MAY 7, 1953: THAT THE TIE FOR LOCATION IS MADE DIRECT TO THE NORTH 1/4 COR. SEC. 21, T13S, R20E, W.M. AS SHOWN.

Fred D. Gustafson

22717