


SECTION 9, T. 40 S., R. 3 E., W. M.

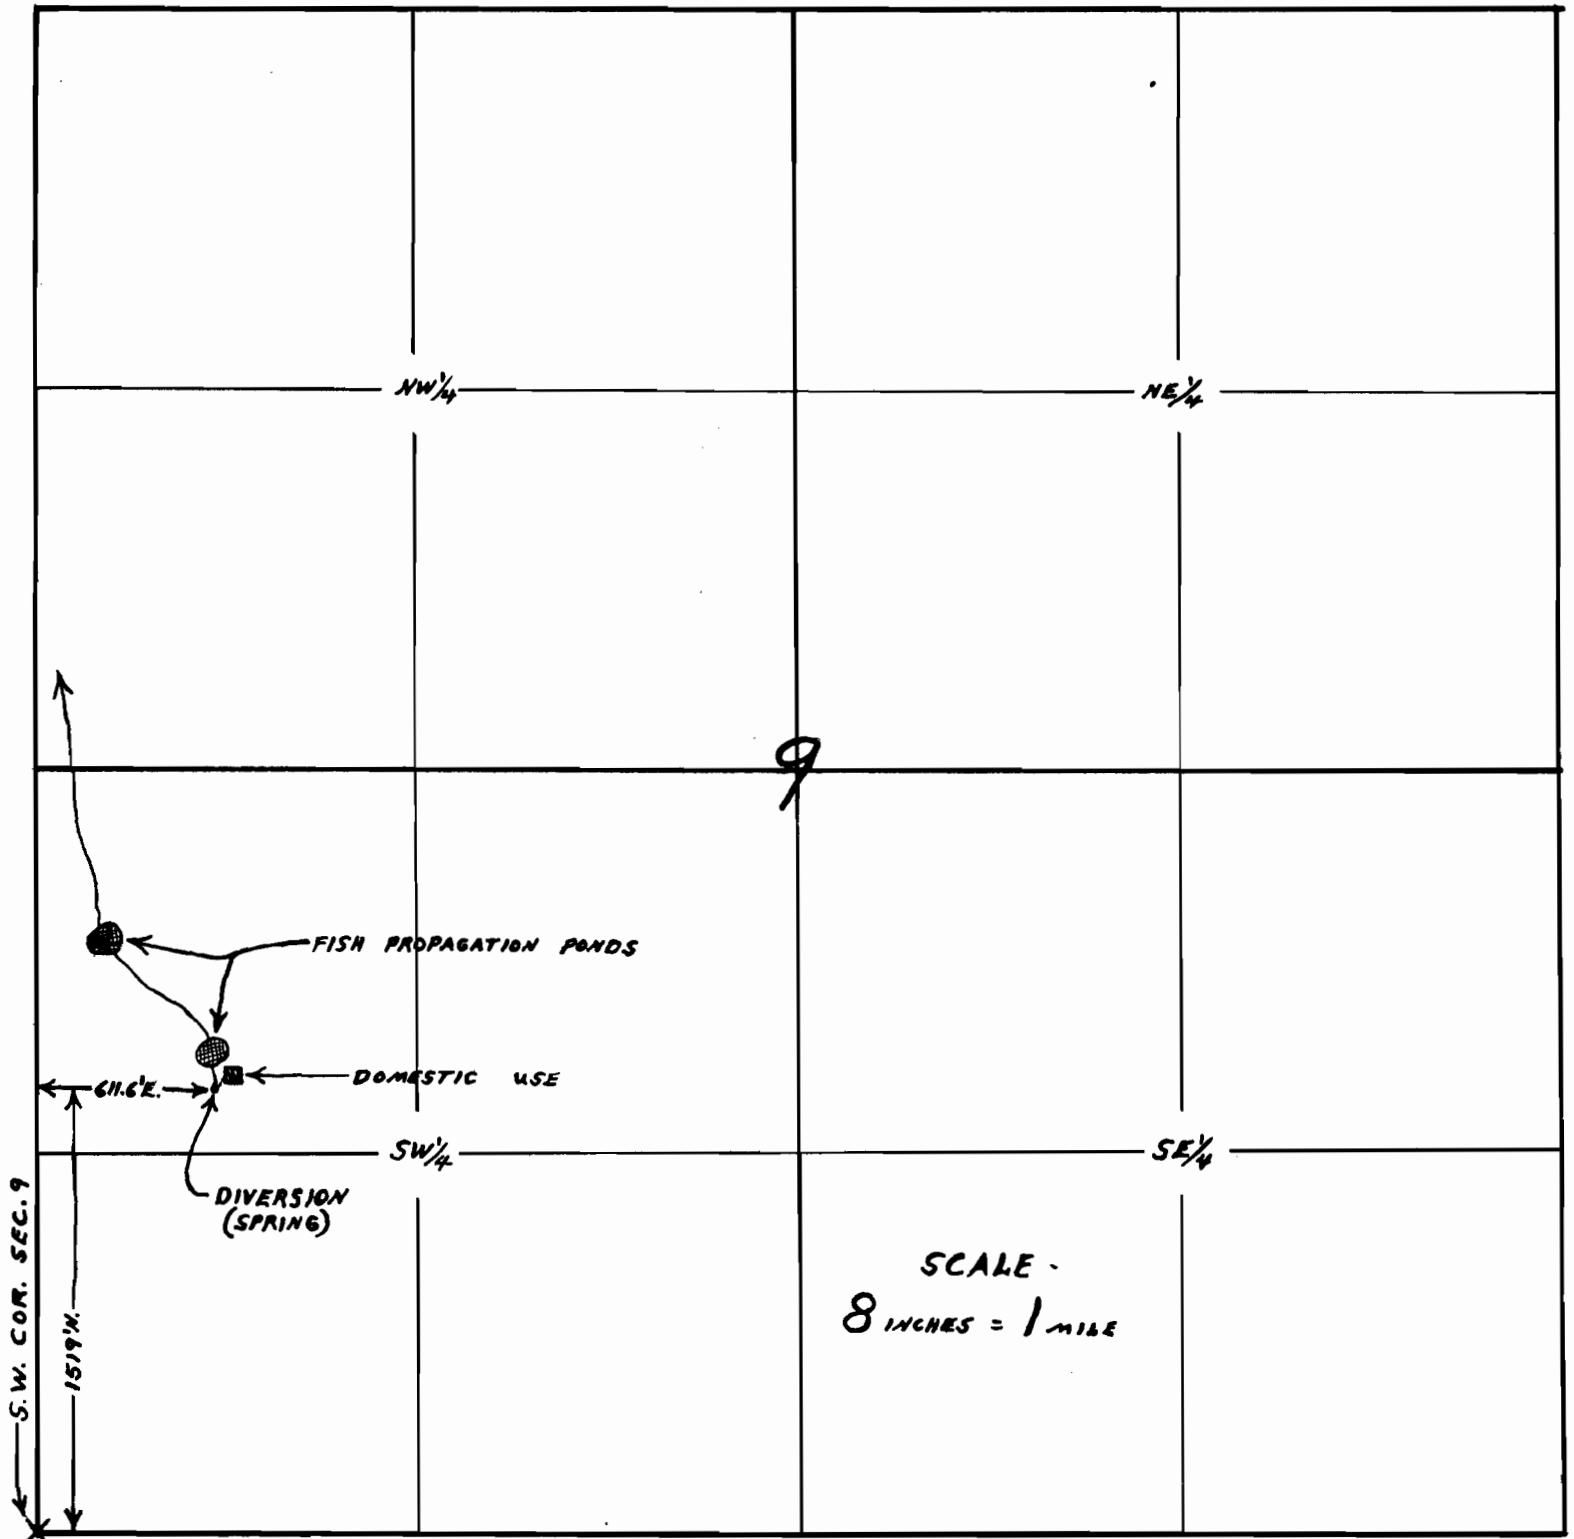

MAP TO ACCOMPANY APPLICATION OF
A.W. MCOAT FOR USE OF WATER FROM
A SPRING FOR FISH PROPAGATION AND
DOMESTIC PURPOSES.

THIS OFFICE 11-25-53
David b. Hendrix

Application No. 28918
Permit No. 22759