





SECTION 30

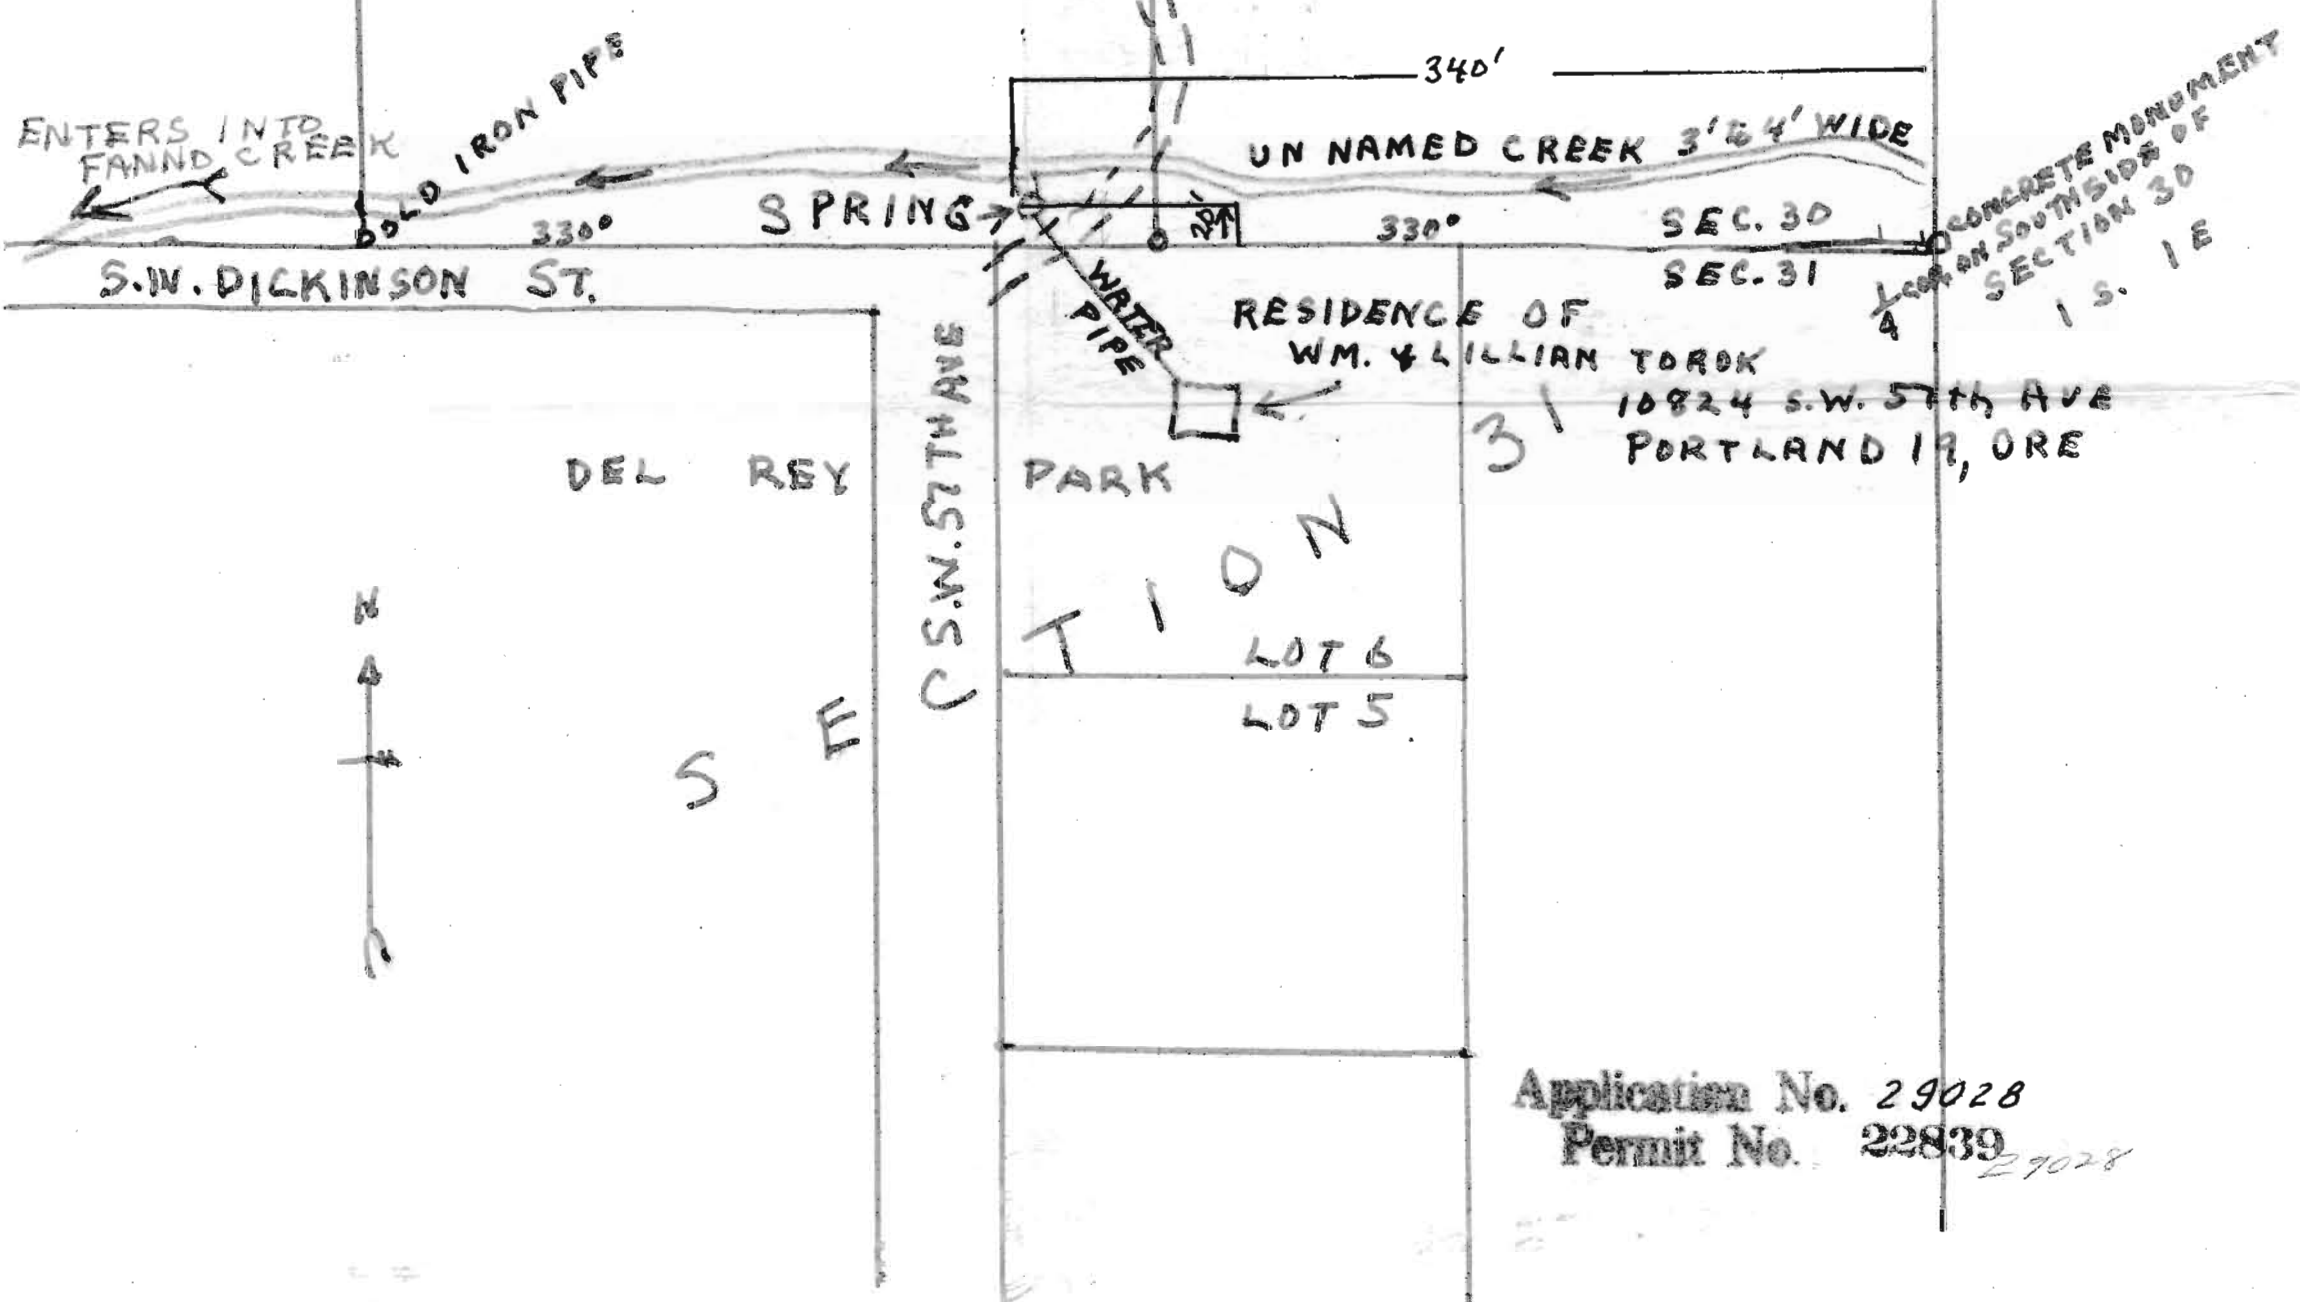

Application No. 29028
Permit No. 22839