


T. 36 S., R. 6 W., W. M
Scale 4" = 1 Mile April 1954
C. A. Antill

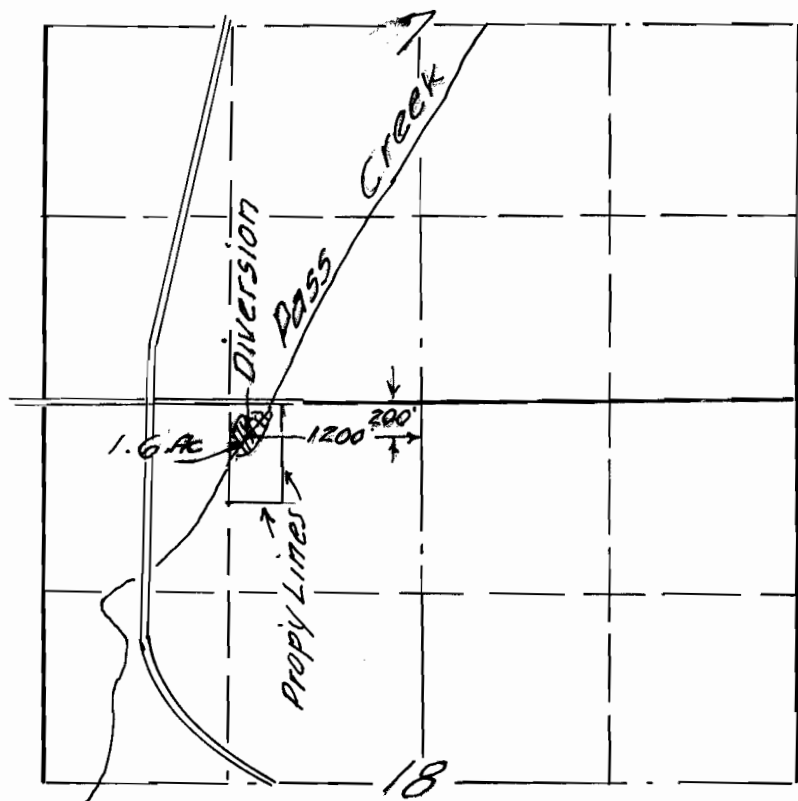

Rogue River

Application No. 29113
Permit No. 22880