


T 37 and 38 S. R. 5 W., W. M.
Scale 4"=1 Mile. April 1954

A. K. Jones.

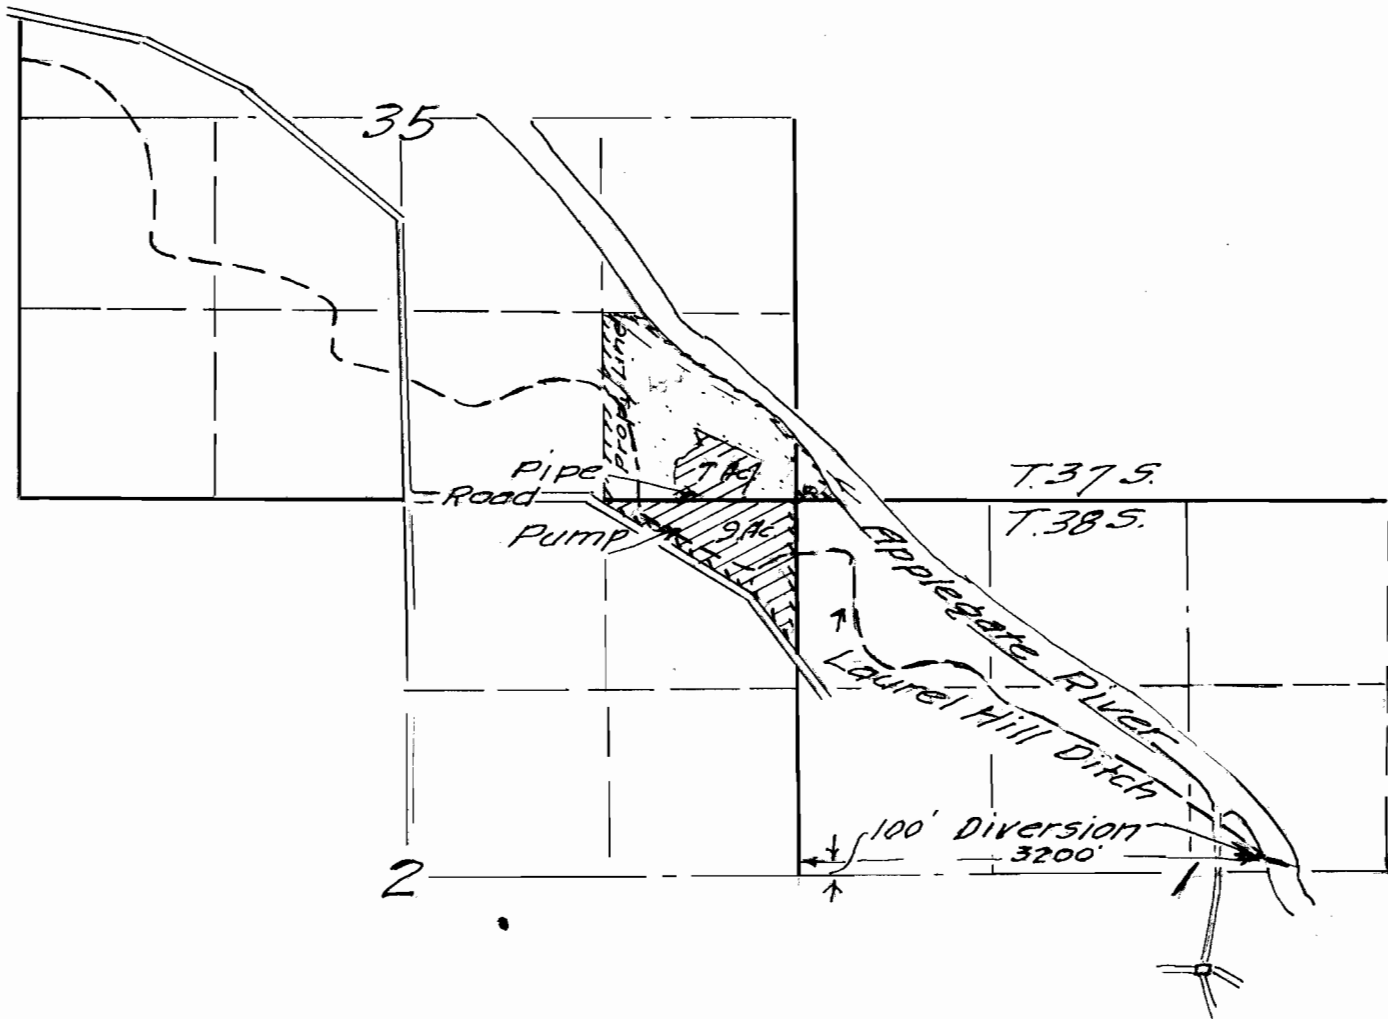

Application No. 29114
Permit No. 22881

29114