

**PLAT OF
M'QUEEN'S ADDITION**

**TO
COTTAGE GROVE
OREGON**

Know all men by these presents that I Ivan McQueen a single man am the sole owner of the land marked and designated upon the accompanying plat as Iowa Street, Ohio Street, Third Street and Cherry Street, also of the alley lying between lots 1 & 2, Block No 3 and that I hereby dedicate to the public and for the public use all the above named streets and alley; that I am the sole owner of all the land in blocks No 1-3 & 4 and lots 4-5-6-7 & fractional lot A, in block No 2; George W. McQueen being the owner of lots 1-2 & 3 in block No 2

In witness whereof I have hereunto set my hand and seal this 31st day of May A.D. 1904
Ivan McQueen (Seal)

Done in presence of
A. E. Wheeler
Jessie Livormore


State of Oregon
County of Lane

On this the 31st day of May A.D. 1904 personally came before me, a Notary Public in and for said County, the within named Ivan McQueen, personally known to me to be the identical person described in, and who executed the within instrument, and acknowledged to me that he executed the same, and voluntarily for the uses and purposes named therein.

Witness my hand and seal this 31st day of May A.D. 1904

(Notarial Seal)

A. E. Wheeler
Notary Public for the State of Oregon

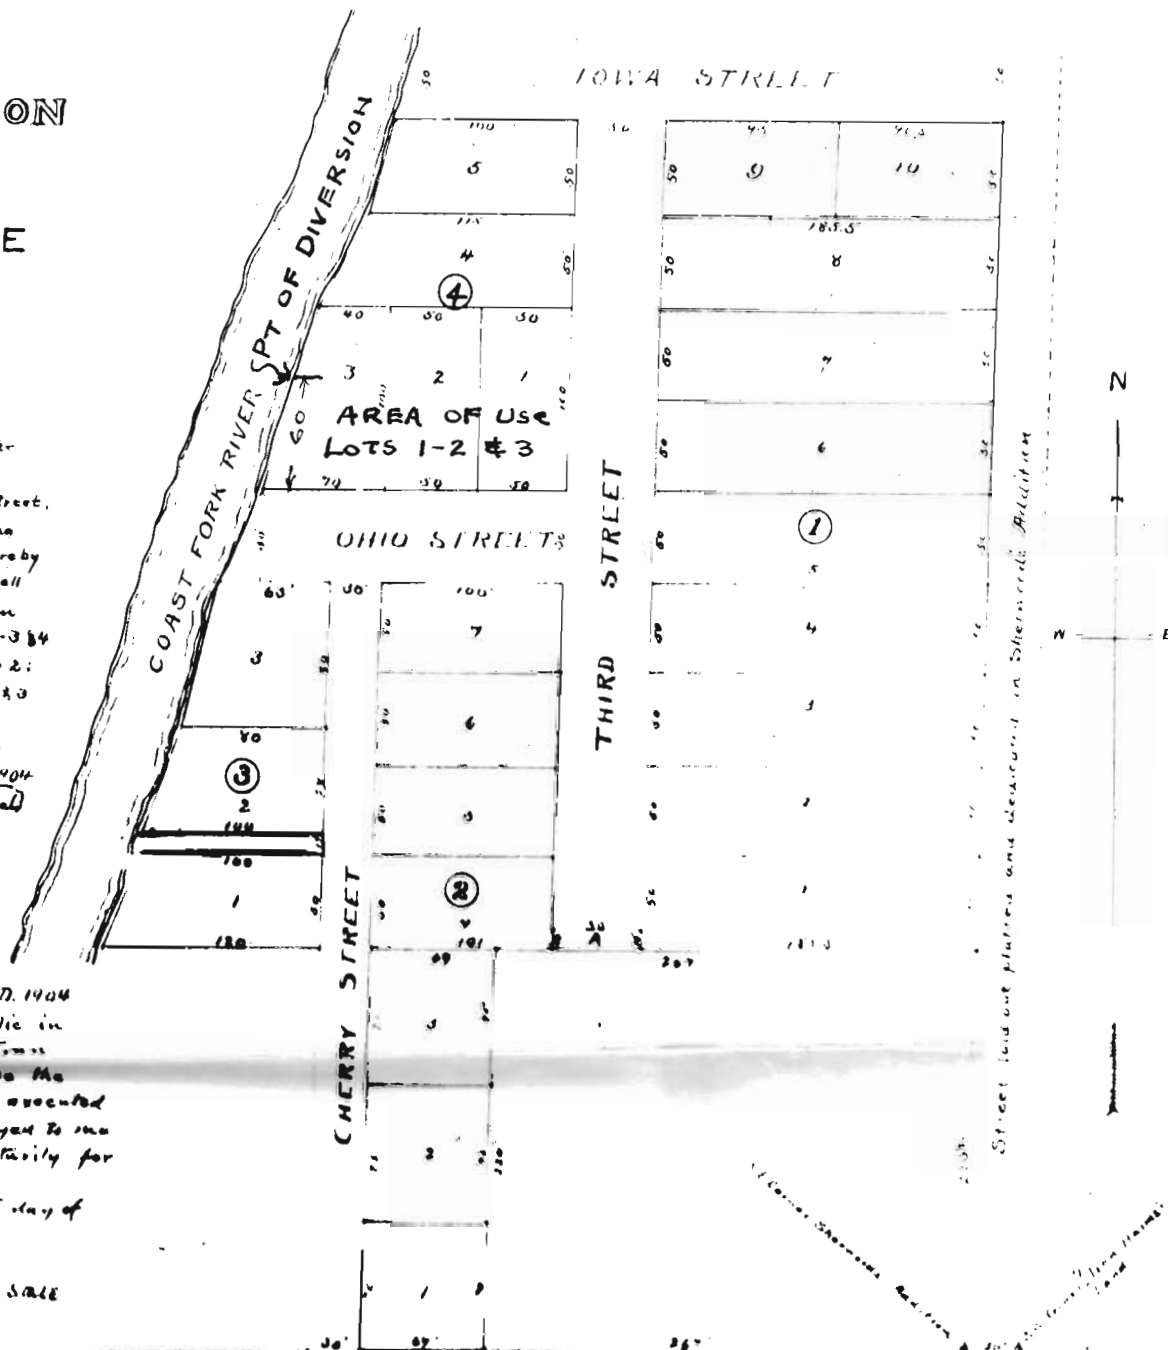

Scale 60' to 1"

Explanation
The land included in this plat is part of the land formerly platted in Sherwood's Addition to Cottage Grove, and its boundaries conform in direction to those in Sherwood's Addition. Third Street and Cherry Street being parallel to the east line of Sherwood's Addition, and Ohio and Iowa Streets run east and west parallel to the south line of Sherwood's Addition, and to Main Street Cottage Grove.

I hereby certify that the above plat of McQueen's Addition to Cottage Grove, Or., was submitted to the Council of Cottage Grove on the 16th 1904 and by them approved.

A. E. Wheeler
City Recorder

STATE OF OREGON }
LANE COUNTY }
I hereby certify that
the within instrument is filed for record
this 31st day of May 1904, at
12 o'clock, P. M., and duly
recorded in Book 2 page 69
Lane County, that records

RECEIVED
MAY 2 1904
STATE ENGINEER
SALEM, OREGON

Application No. 29099
Permit No. 22918