


T. 35 S., R. 8 W., W. M.

Scale 400' = 1"

July 1954

David Prow.

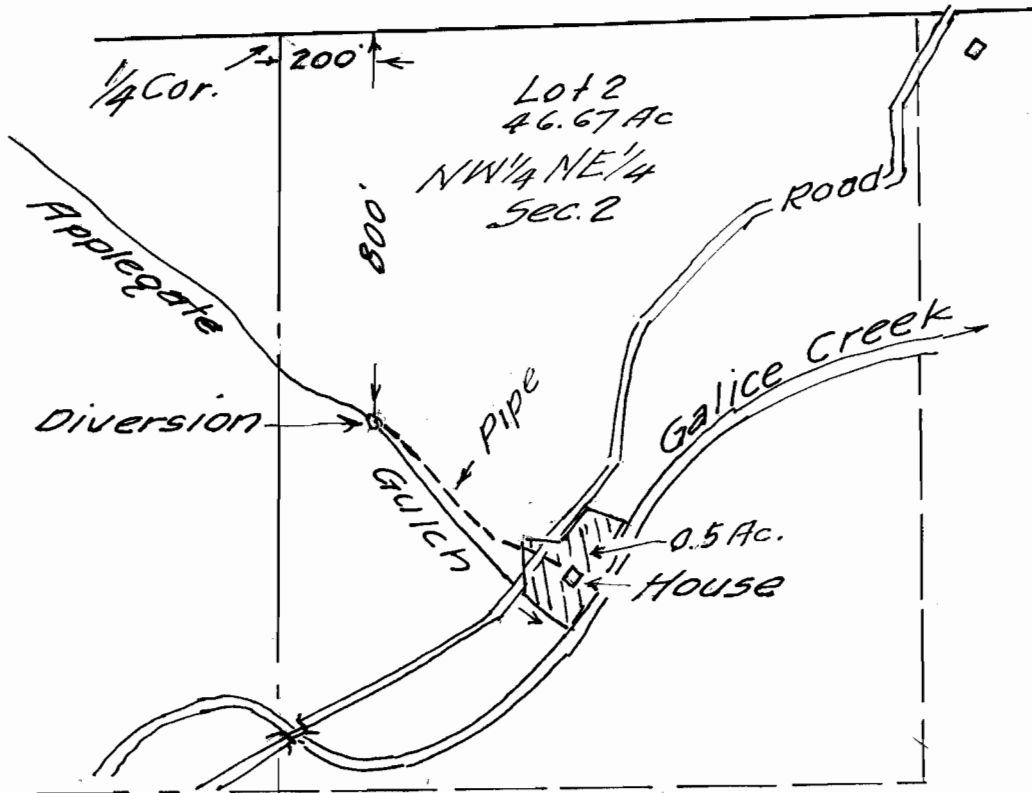

RECEIVED  
JUL 7 1954  
STATE ENGINEER  
SALFORD, CALIF.

Cent. Sec.  
2

Application No. 29310  
Permit No. 33033