


T. 36 S., R. 7 W., W. M.
Scale 100' = 1" Sept. 1954
James B. Stine and Anna H. Stine.

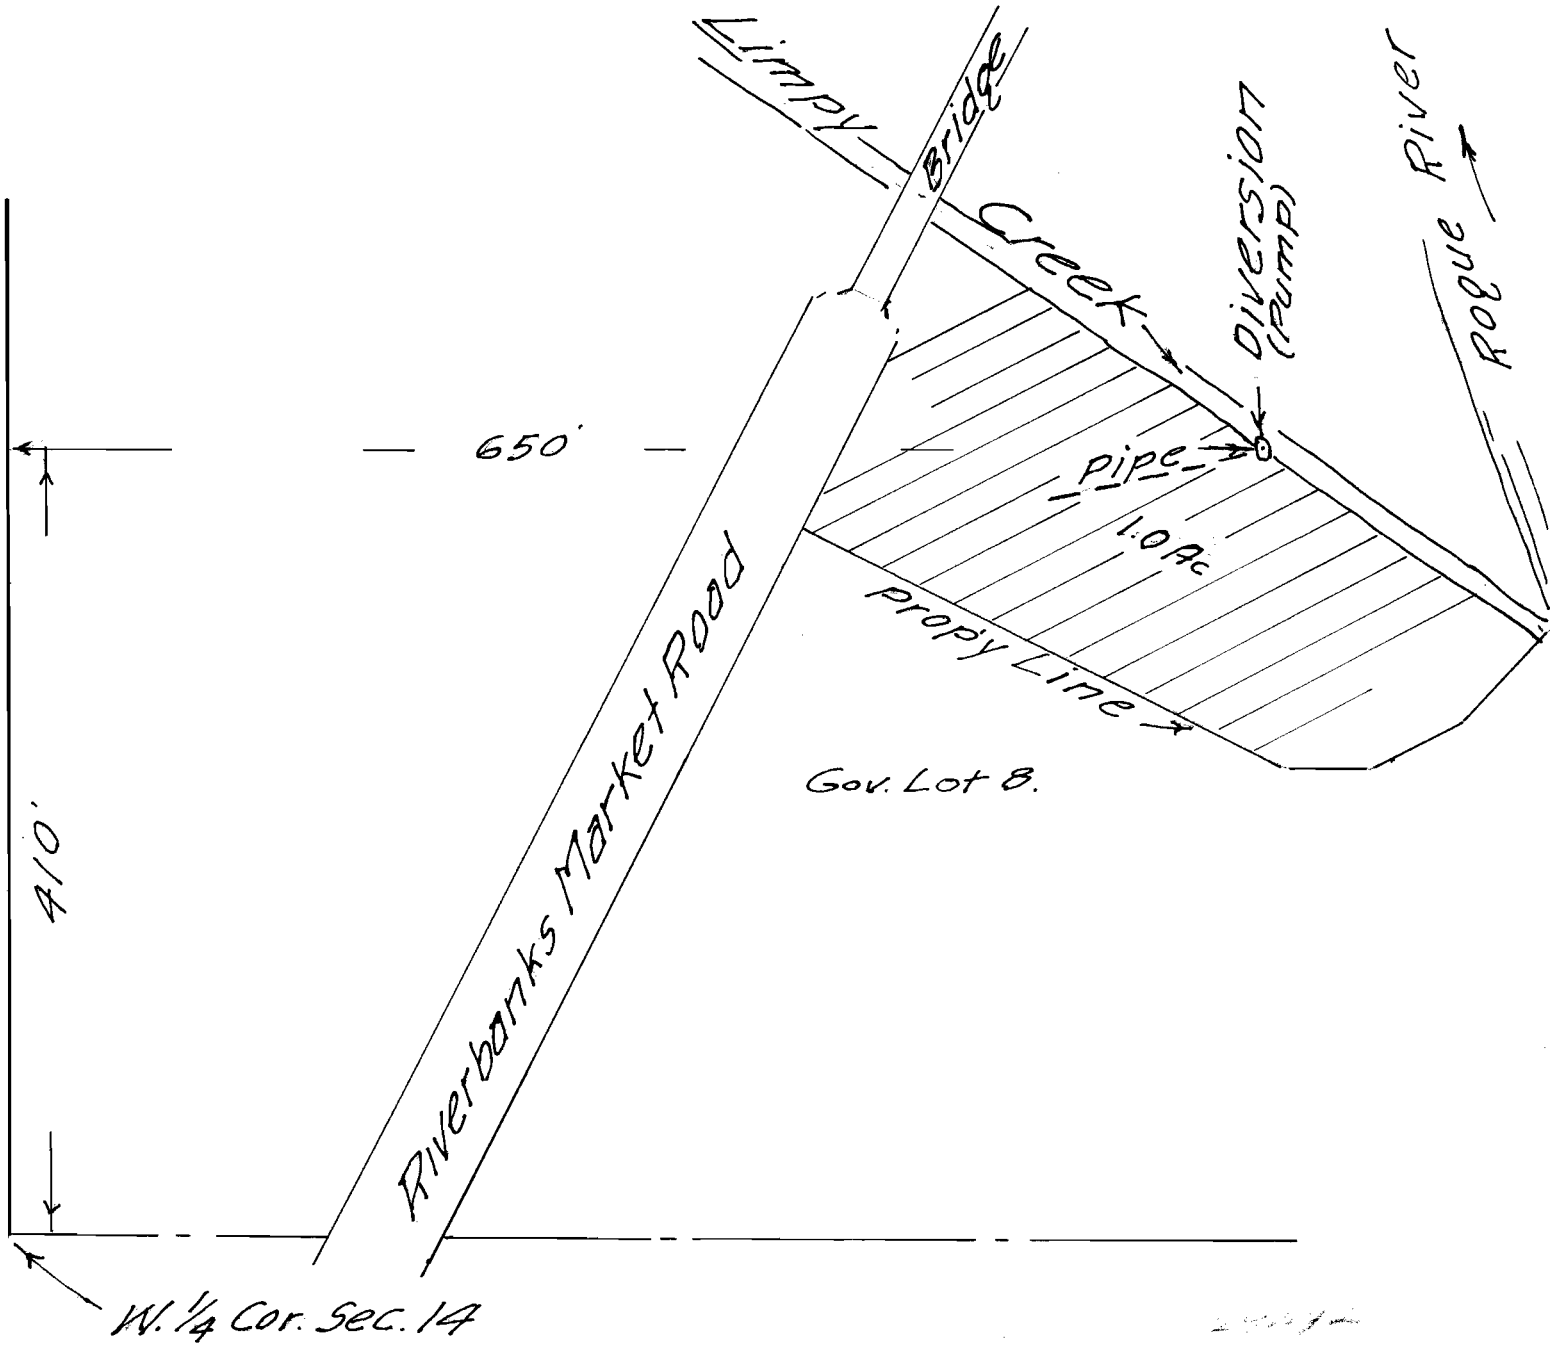

Application No. 29492
Permit No. 23200