


T 4 N R 9 W

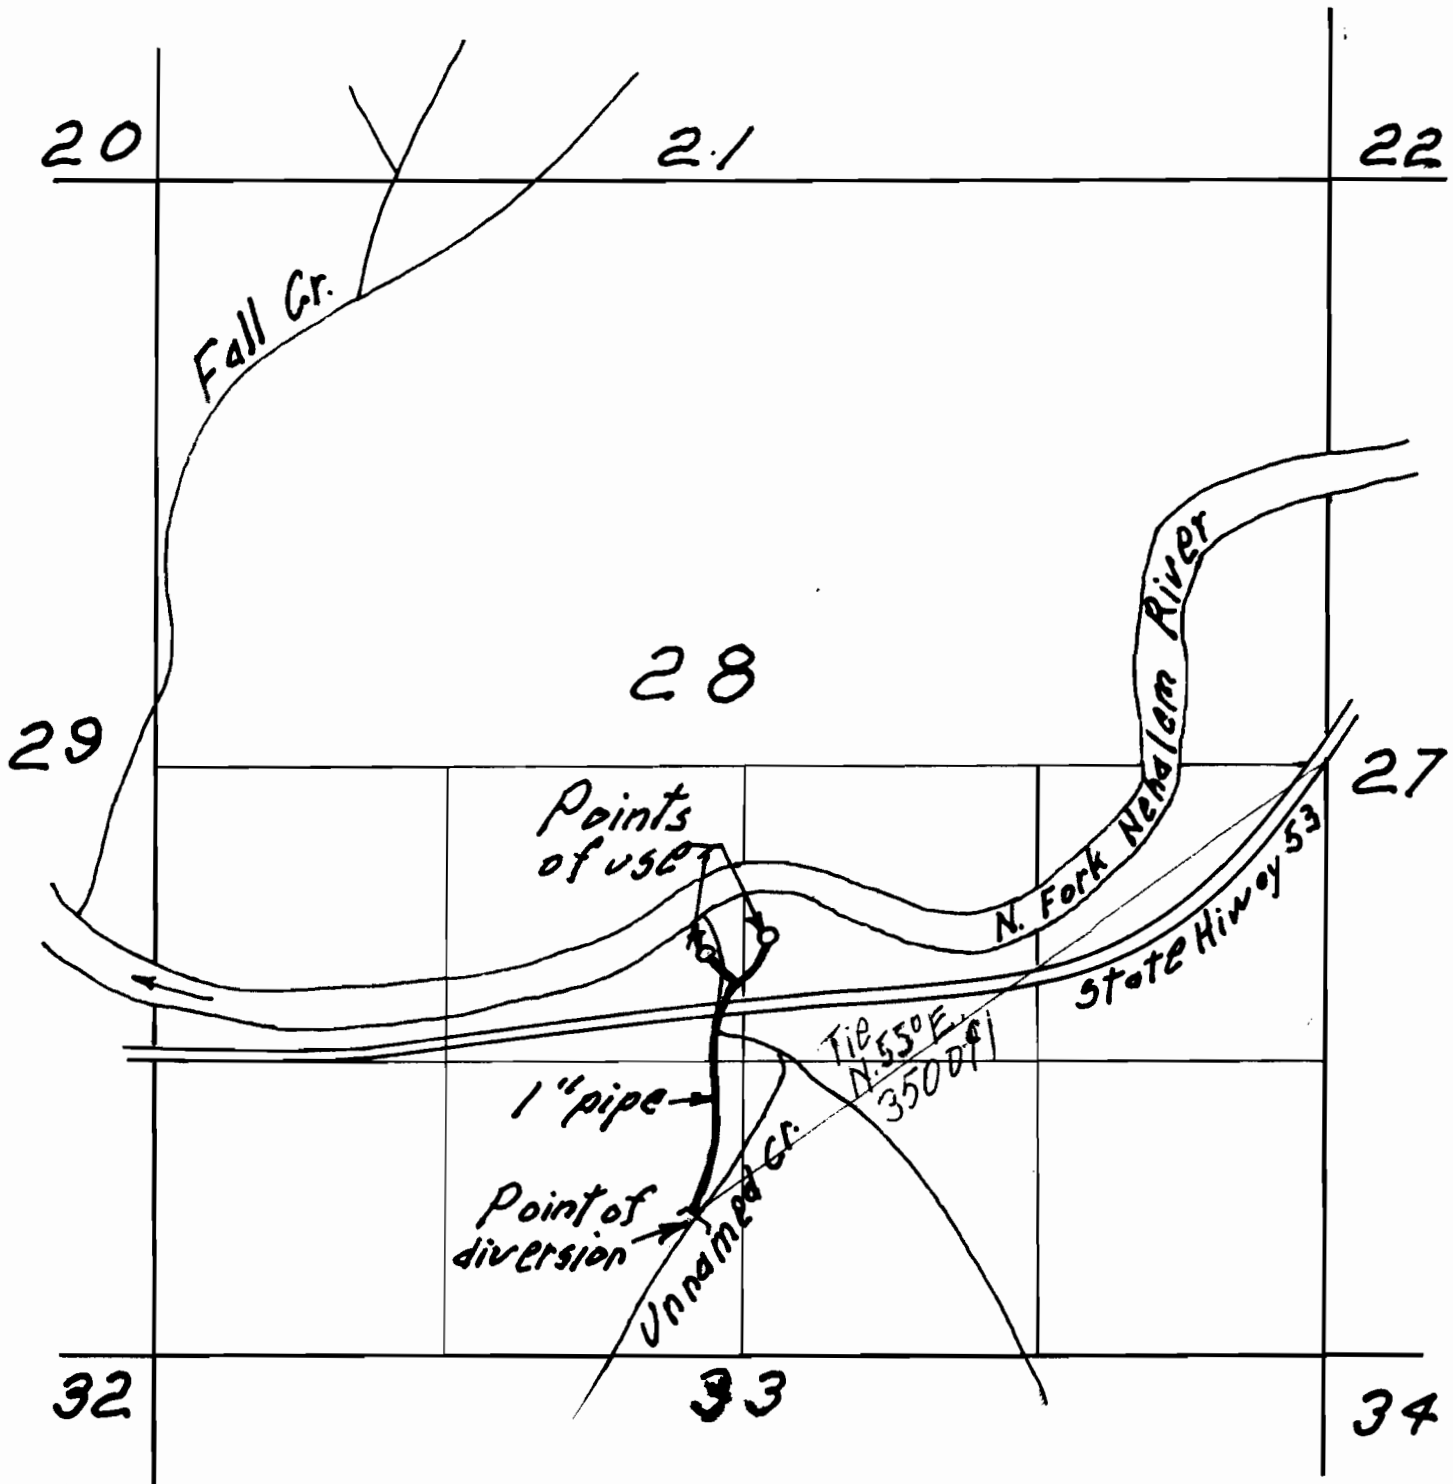

Scale: 6" = 1 mile

Application No. 29522  
Permit No. 23246