


17 | 16
20 | 21

R. G. W

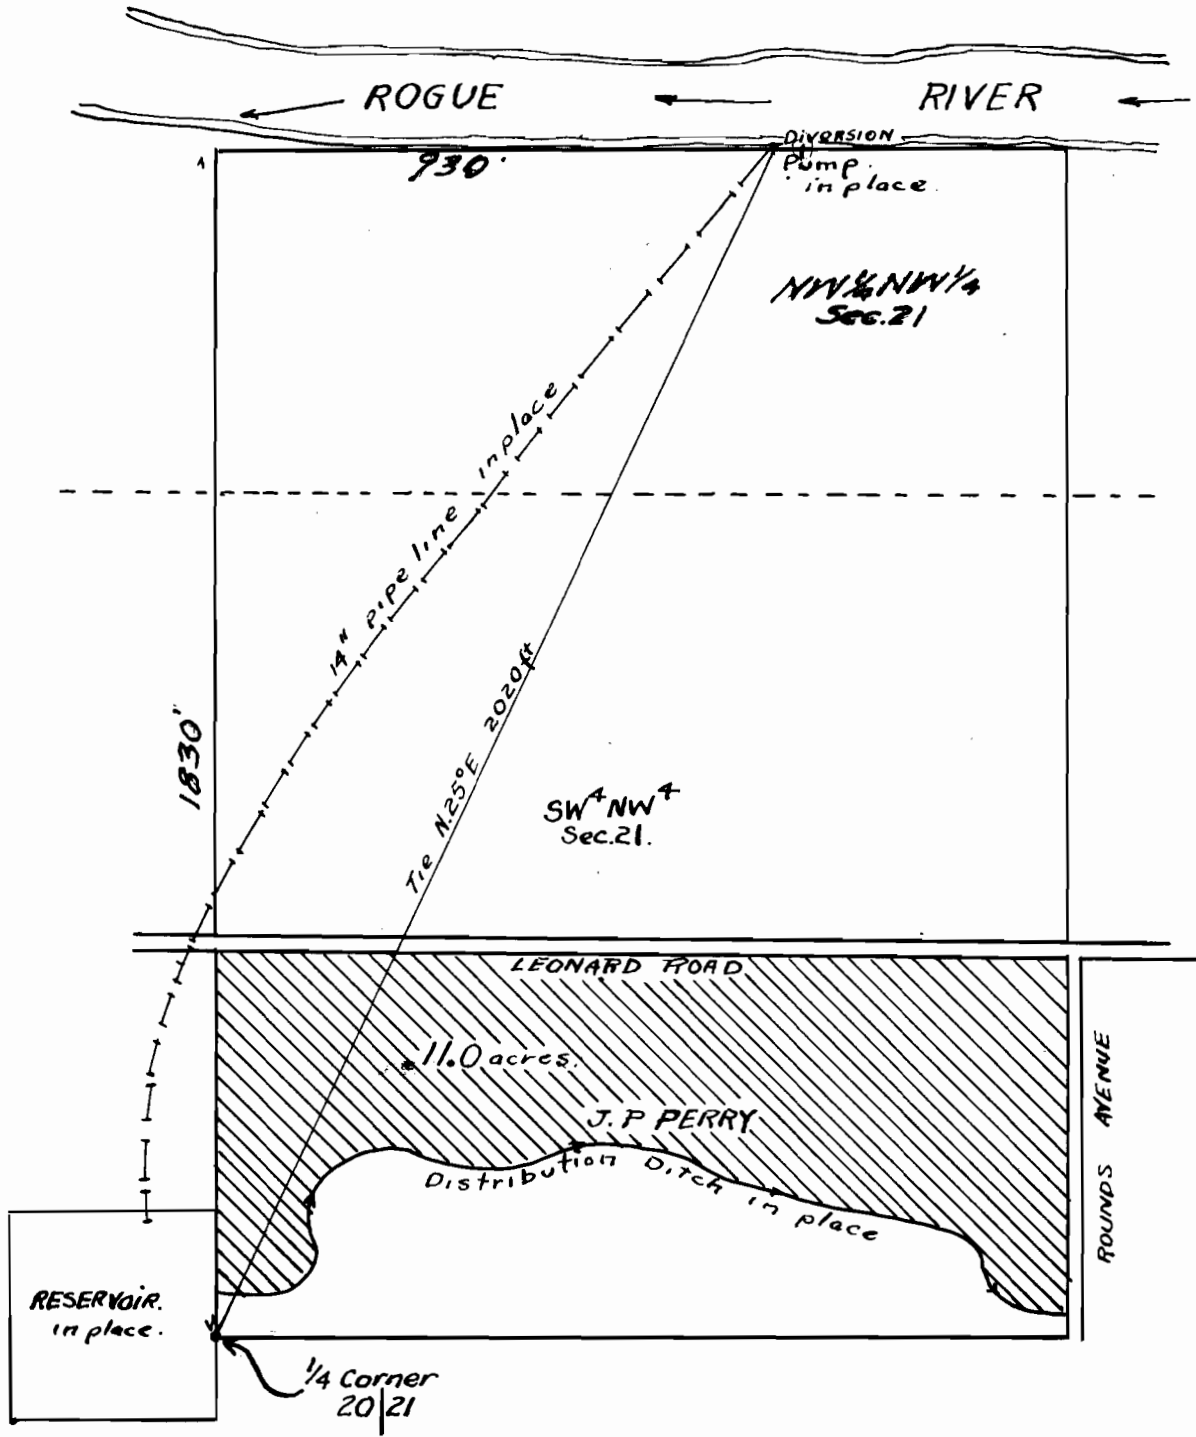

T.
36
S.

Scale 300' = 1inch

Application No. 29906
Permit No. 23820

29906