


County Road

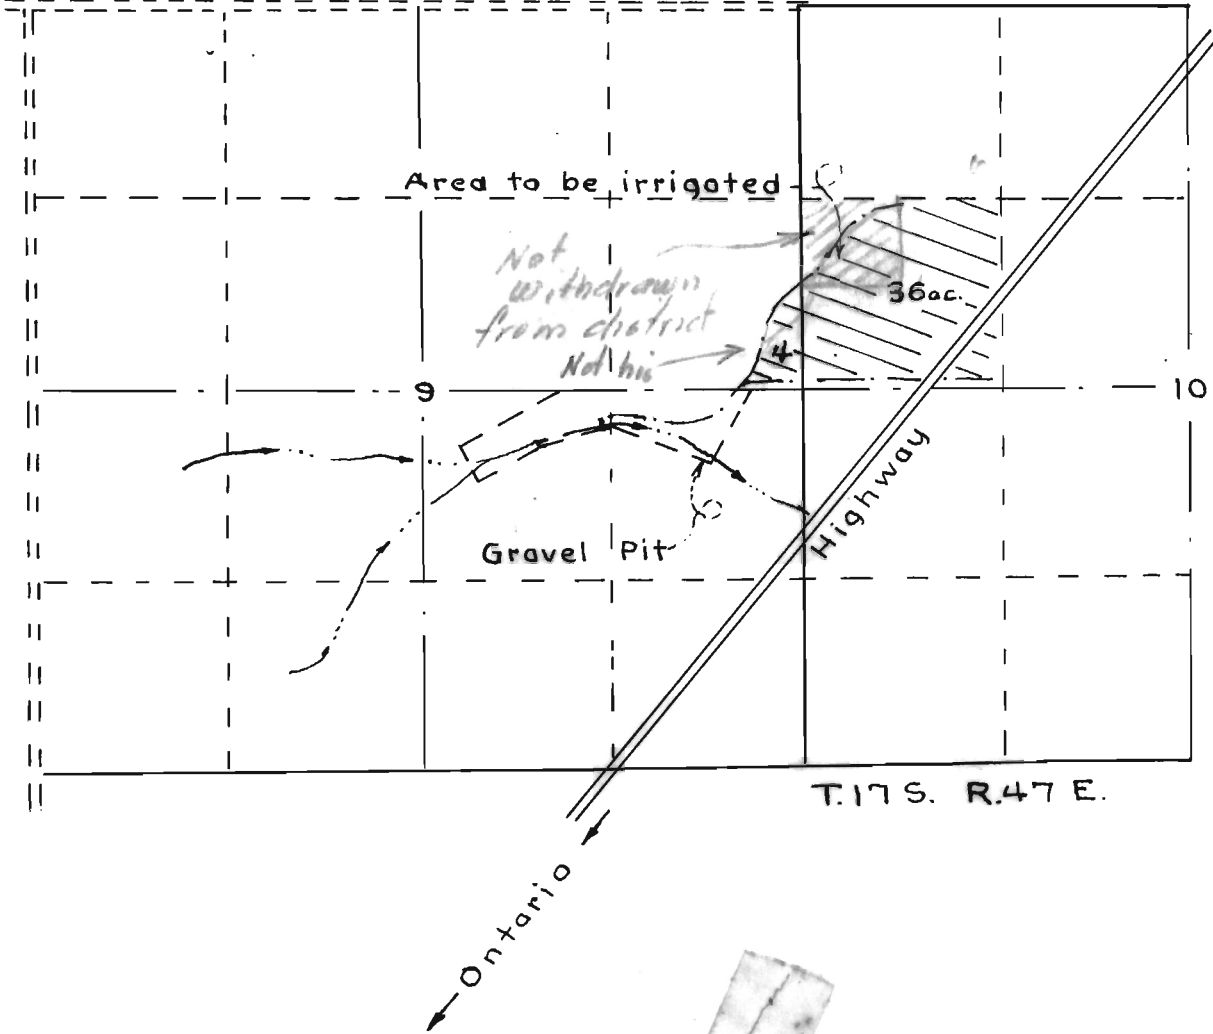

Application No 29624, Permit No. 23336
Revision ~ Area to be irrigated.
Point of diversion unchanged.

RECEIVED
NOV 16 1955
ENGINEER
OREGON

W.I. Lillinger 10-17-55