


RECEIVED  
JAN 13 1955  
STATE ENGINEER  
WASH. OFFICE

RECEIVED  
JAN 18 1955  
STATE ENGINEER  
WASH. OFFICE

Sec 2 Twp. 7 N. R 8 W.

1"=660'

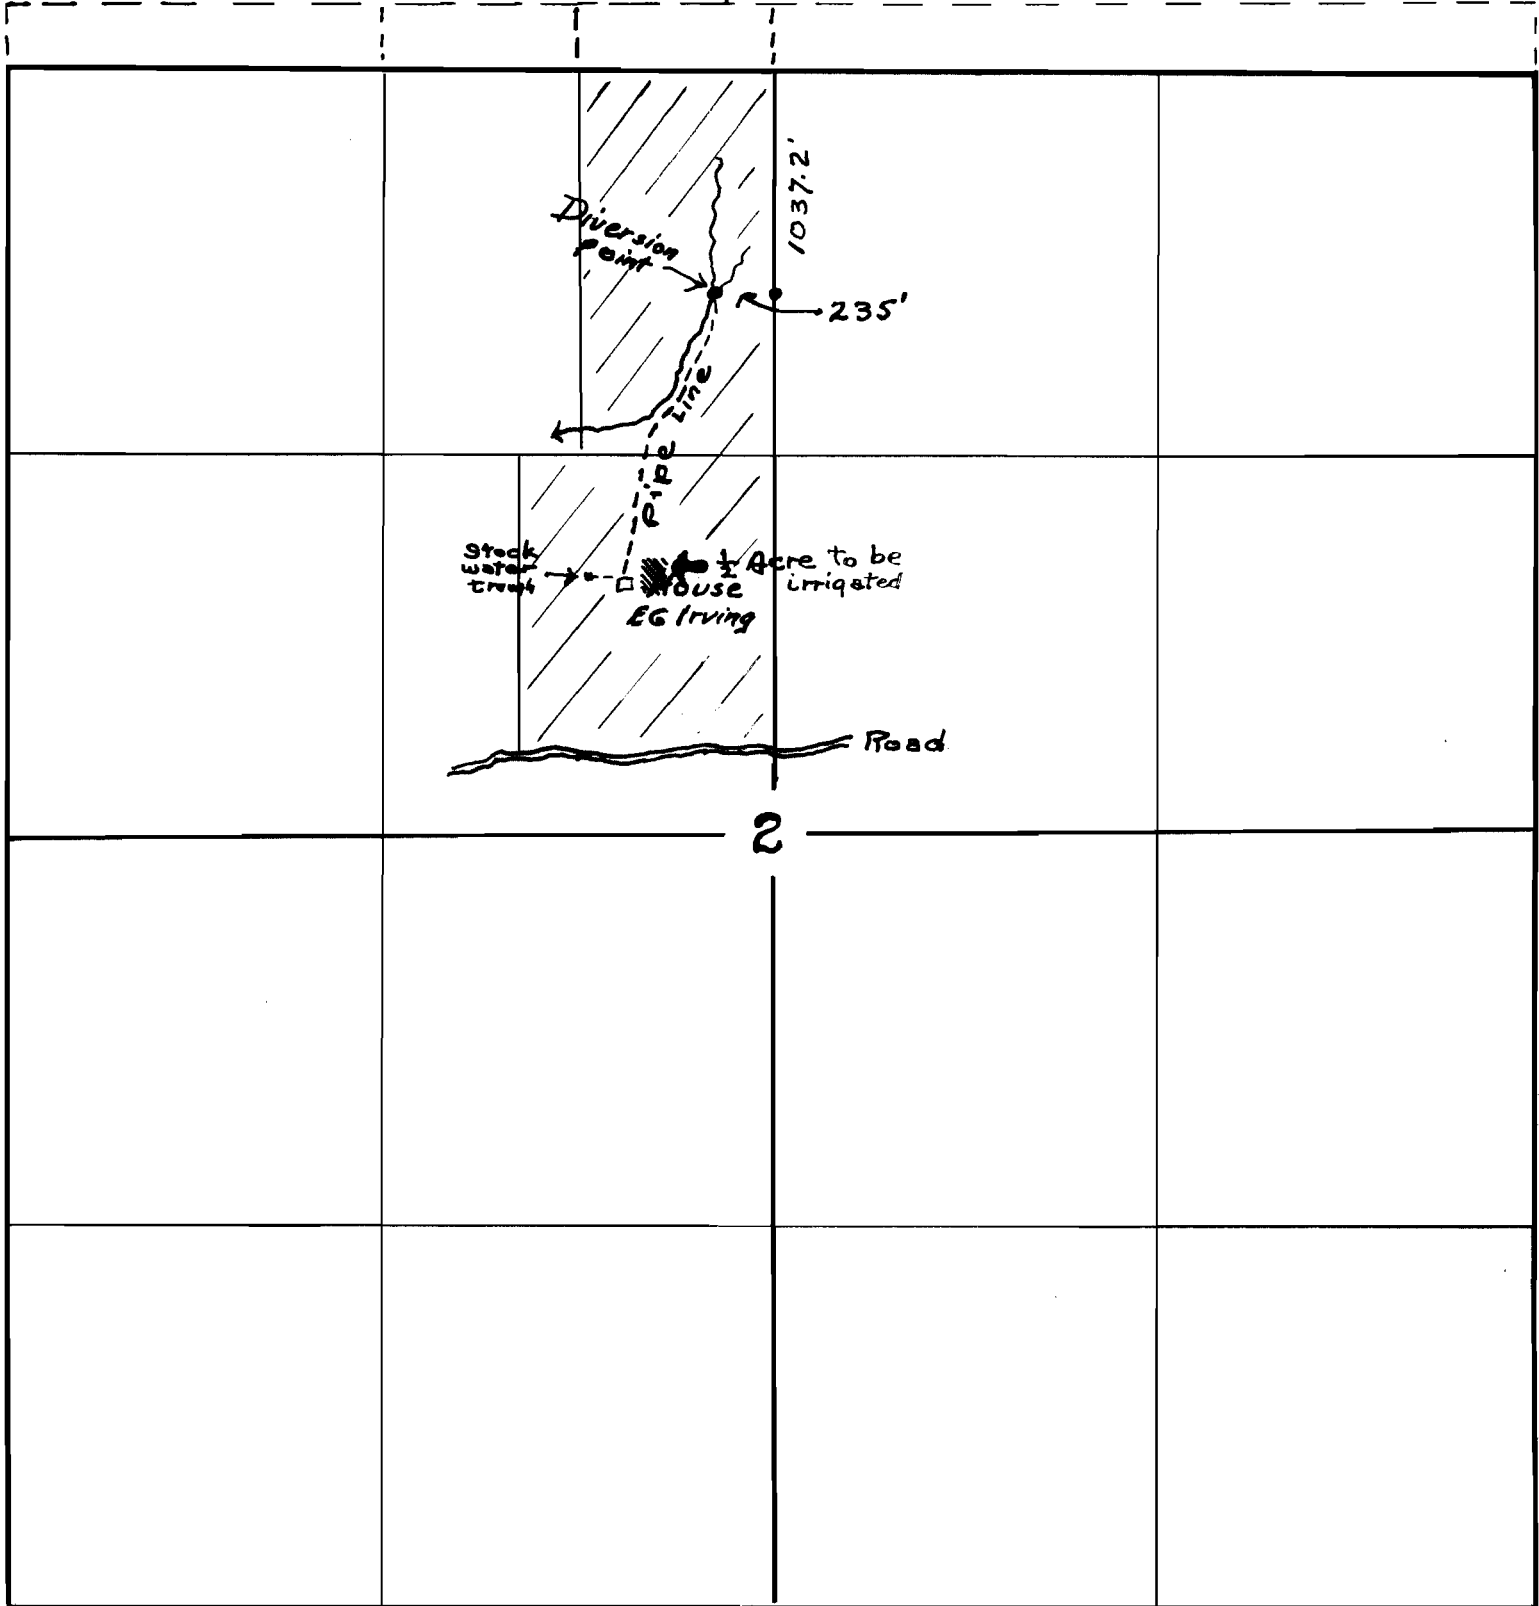

Shaded portion owned by Edwin Glenn Irving  
North forties overrun

Application No. 29662  
Permit No. 23358  
Dec. 30, 1954.