



ZELLA M. JONES
R.T. 1, BOX 746
WEST LINN, OREGON

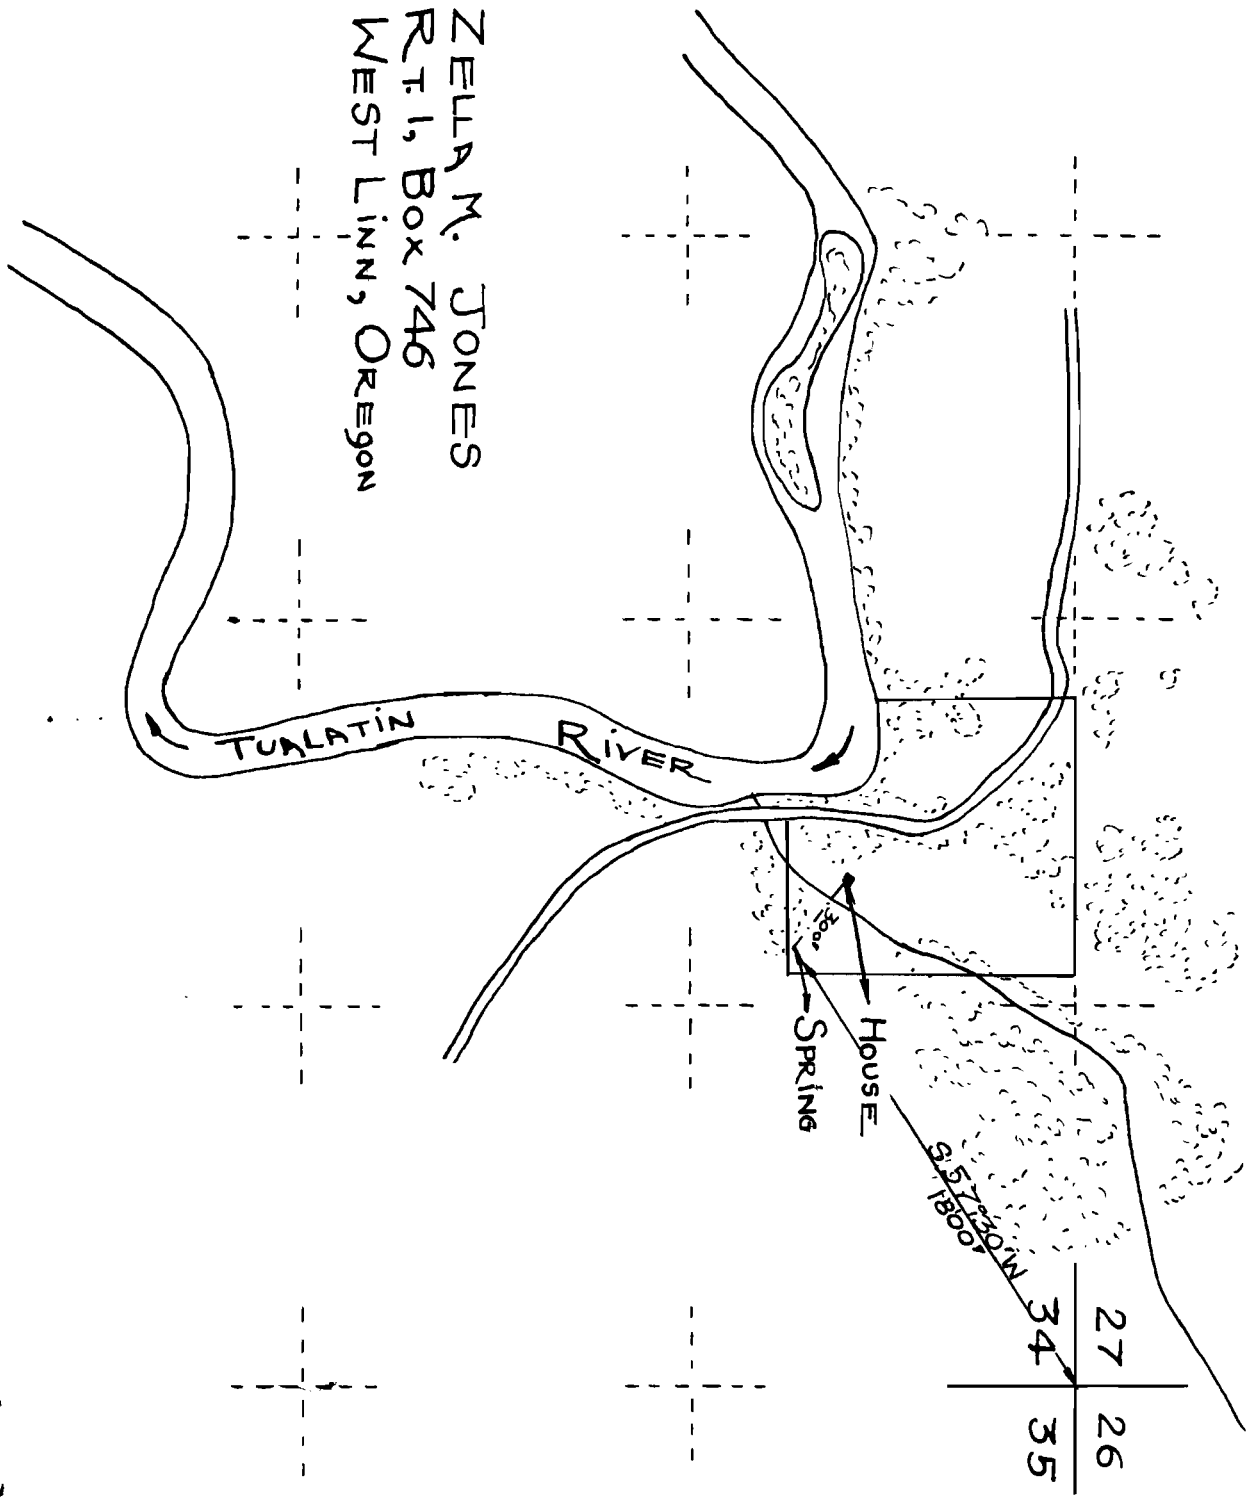

T2S-R1E

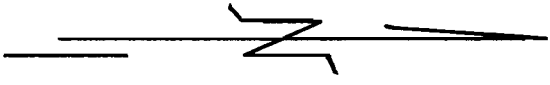

Application No. 27665
Permit No. 23361